

Jon M. Huntsman, Jr. Governor Gary Herbert Lieutenant Governor F. Keith Stepan Director

State of Utah

Division of Facilities Construction & Management

Department of Administrative Services 4110 State Office Building Salt Lake City, Utah 84114 Phone (801) 538-3018 Fax (801) 538-3267

MEMORANDUM

Date: March 3, 2006

To: General Contractors

From: Matthias Mueller

Reference: Division of Facilities Construction and Management

New North Ogden Liquor Store and Demolition And Replacement Of The

Ogden (Patterson Avenue) Liquor Store DFCM Project Nos. 04242030 and 04180030

Subject: Addendum No. 4

Note: This Addendum shall be included as part of the Contract Documents. Items in this Addendum apply to all drawings and specification sections whether referenced or not involving the portion of the work added, deleted. Modified, or otherwise addressed in the Addendum. Acknowledge receipt of this Addendum in the space provided on the Cost Proposal Form.

4.1 Addendum No. 4 Attachments

This addendum consists of two addendum attachments from the AE firms of Frank Murdock Architect & Associates - for the New North Ogden (Harrisville) Liquor Store 04242030 and Eaton Architecture – for the Ogden (Patterson Avenue) Liquor Store 04180030.

END OF ADDENDUM 4

Department of Alcoholic Beverage Control New Harrisville, Utah Liquor Store

Addendum No. A04

Issued Friday March 3, 2006

PROJECT

New Harrisville, Ut Liquor Store
Department of Alcoholic Beverage Control
433 North Main Street, Tooele, Utah
DFCM Project No. 04242030

ARCHITECT

Frank N Murdock Jr Architect & Associates 975 East 100 South Salt Lake City, Utah 84102 (801) 532-4441

The original Contract Documents issued for the above noted project are amended as noted in this Addendum. It shall be the sole responsibility of the bidder to appropriately disseminate this data to all concerned, prior to the assigned bid time and date.

Receipt of this Addendum shall be acknowledged by inserting its number and date in the appropriate space provided on the bid form.

This document identifies changes made to the construction documents and may not be all-inclusive of the changes. Please refer to clouded changes on the re-issued and new drawings accompanying this Addendum.

Drawing AS101 has been re-issued with the following changes:

- 1.1 The handicap parking stalls have been modified and clouded. The built-up curb ramp has been eliminated and the sidewalk has been modified to provide a ramp to either direction (see Drawing AS501, note 2, below).
- 1.2 The north arrows have been rotated and clouded to reflect the correct orientation of the building and the site.
- 1.3 "Reference Note J" has been changed to reflect the location and description of the vinyl fence.
- 1.4 The termination of the vinyl fence on the north property line has been dimensioned and clouded.

Drawing AS102 has been re-issued with the following change:

1.1 The north arrow has been rotated and clouded to reflect the correct orientation of the building and the site.

Drawing AS103 has been re-issued with the following changes:

- 1.1 The north arrow has been rotated and clouded to reflect the correct orientation of the building and the site.
- 1.2 The culinary water line into the building shall be 1 1/2" diameter. The sanitary sewer line leaving the building shall be 4" diameter. Notes to this effect have been added and clouded.
- 1.3 Provide a 1 1/2" water meter and a 1 1/2" x 1 1/2" x 1 1/2" tee for the landscape sprinkling system. Notes to this effect have been added and clouded.

Drawing AS501 has been re-issued with the following changes:

- 1.1 Detail 2/AS501 has been modified and clouded to show a change in the mounting height for the Handicapped Parking signs.
- 1.2 Detail 15/AS501 has been modified and clouded to show the new access from the two customer handicap parking stalls to the front sidewalk of the building (see Drawing AS101, note 1.1, above).

Drawing A101 has been re-issued with the following changes:

- 1.1 Particle board wainscot is now shown on the floor plan and is represented by a dashed line. The detail for the particle board wainscot is Detail 3/A101 and a note referring to the wainscot is has been added at the bottom of the floor plan and clouded.
- 1.2 Dimension of the wall at the office has been added and clouded on Section 9/A101.
- 1.3 The wall near Door 09 has been dimensioned for location and length and clouded.
- 1.4 The three (3) contractor-provided display cabinets at the front of the store have been noted as Detail ADD-2 and clouded.
- 1.5 One owner-furnished display cabinet located near the office and near Grid 3 has been lengthened to 8'-0", which affects the recessed slab for the thick-set floor tile. The cabinet and location have been clouded.
- 1.6 Wall Type 1 and its description has been added and the applicable walls have been tagged on the floor plan.
- 1.7 Section 10/A101 has been modified.

Drawing A102 has been re-issued with the following changes:

- 1.1 The location of the north/south ceiling expansion joint has been changed and clouded.
- 1.2 The note regarding ceiling installation and bracing has been revised and clouded.

Drawing ADD-1 (new):

1. Drawing, ADD-1, showing the profile and a section of the employee entrance ramp at the rear of the building, has been included.

Drawing ADD-2 (new):

1. Drawing ADD-2, detailing the three (3) contractor-furnished display cabinets, has been included.

Specifications:

1. Section 9900 Painting. Add the following:

CONCRETE SEALER

A. Penetrating Sealer: Water repellant coating for use over exterior sandblasted concrete, concrete masonry block, vertical pre-cast concrete and interior exposed concrete floors:

1. Dayton Superior: Weather Worker S-20 (20% Silane)

Tamms: Baracade Silane 20
 Sonneborn: Penetrating Sealer 20

The document, "Mechanical Compliance Certificate, 2003 IECC", comprising two (2) pages, is attached to this addendum and identified as Attachment #1.

The document, "Mechanical Requirements Description, 2003 IECC", comprising two (2) pages, is attached to this addendum and identified as Attachment #2.

The document, "Lighting Application Worksheet, 2003 IECC", comprising one (1) page, is attached to this addendum and identified as Attachment #3.

The document, "Lighting Compliance Certificate, 2003 IECC", comprising two (2) pages, is attached to this addendum and identified as Attachment #4.

The document, "Electrical Addendum", comprising two (2) pages, is attached to this addendum and identified as Attachment #5.

The document, "Structural Addendum", comprising five (5) pages, is attached to this addendum and identified as Attachment #6.

The "Code Criteria" shown on Drawing G002 has been revised and is attached to this addendum and identified as Attachment #7.


End of Document


Drawing ADD-1 Employee Entrance Ramp

DETAIL

Architect ake City, Utah & Associates 84102 (801) 532-4

LCOHOLIC BEVERAGE LIQUOR STORE CONTROL

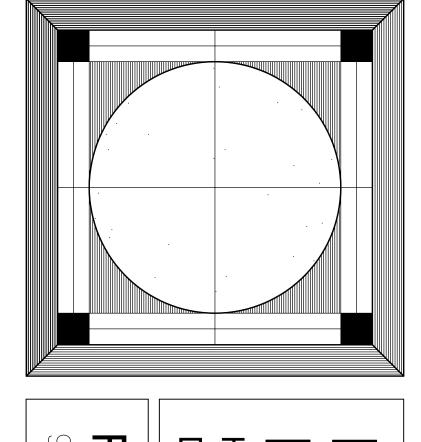


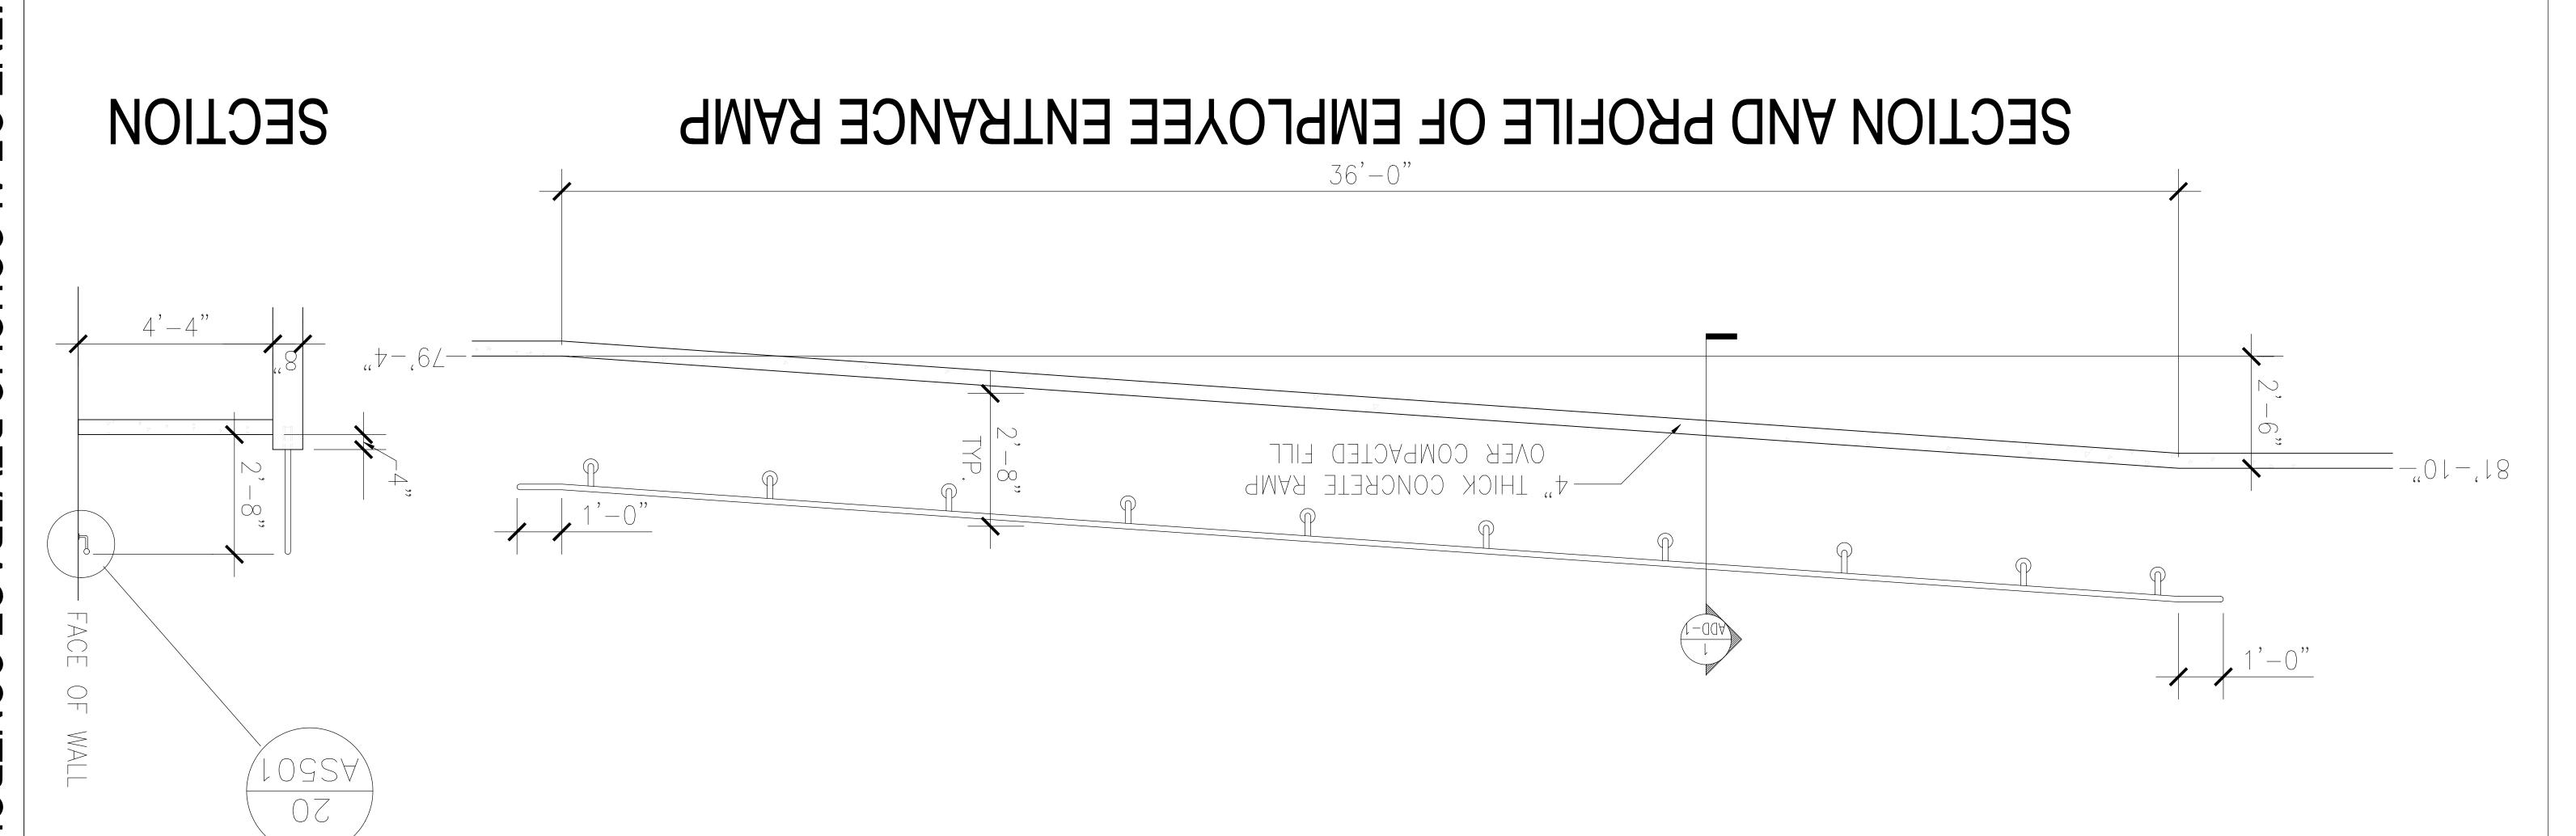

Drawing ADD-2

Contractor-provided Display Cabinets

PROVIDE AND INSTALL 3 (THREE) DISPLAY CASES IN THE NEW HARRISVILLE ABC STORE

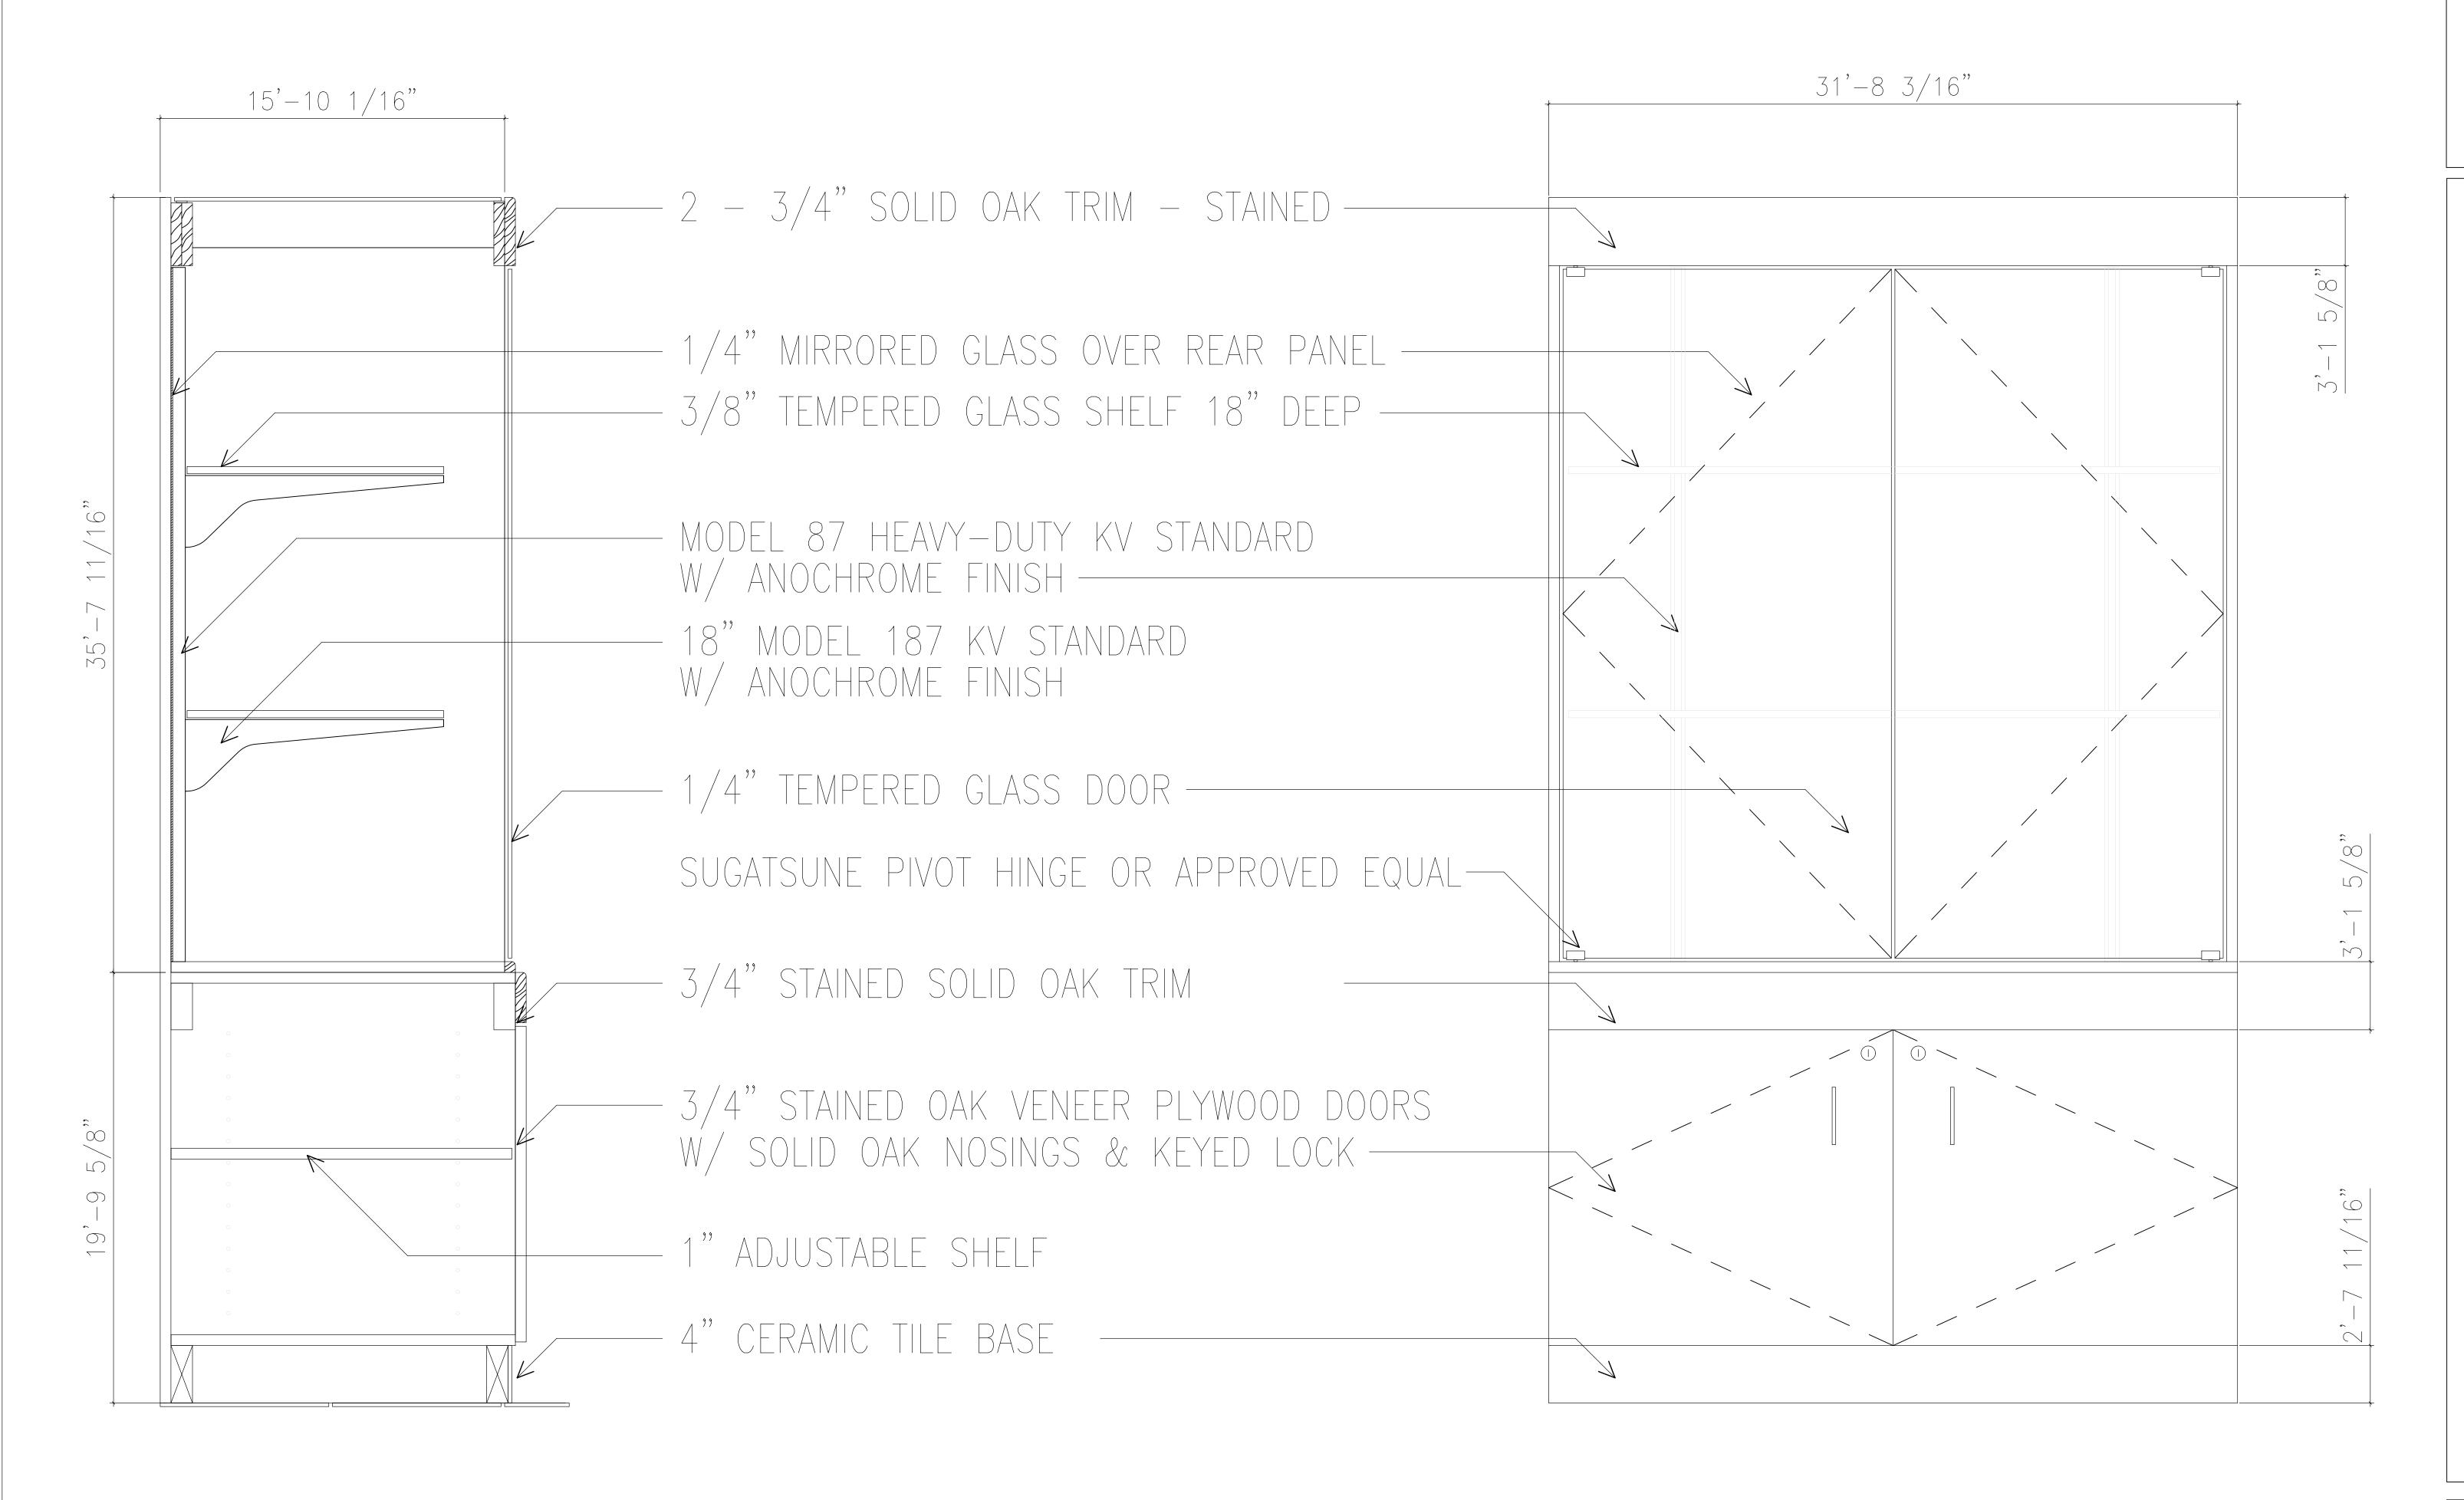

Associates 4102 (801) 532-

1 × ×


FRANK N MURDOCK JR 975 East 100 South Suite 1


DISPLAY CASE SECTIONS AND DETAILS


SCALE: NONE

SECTION

Revised Architectural Drawings

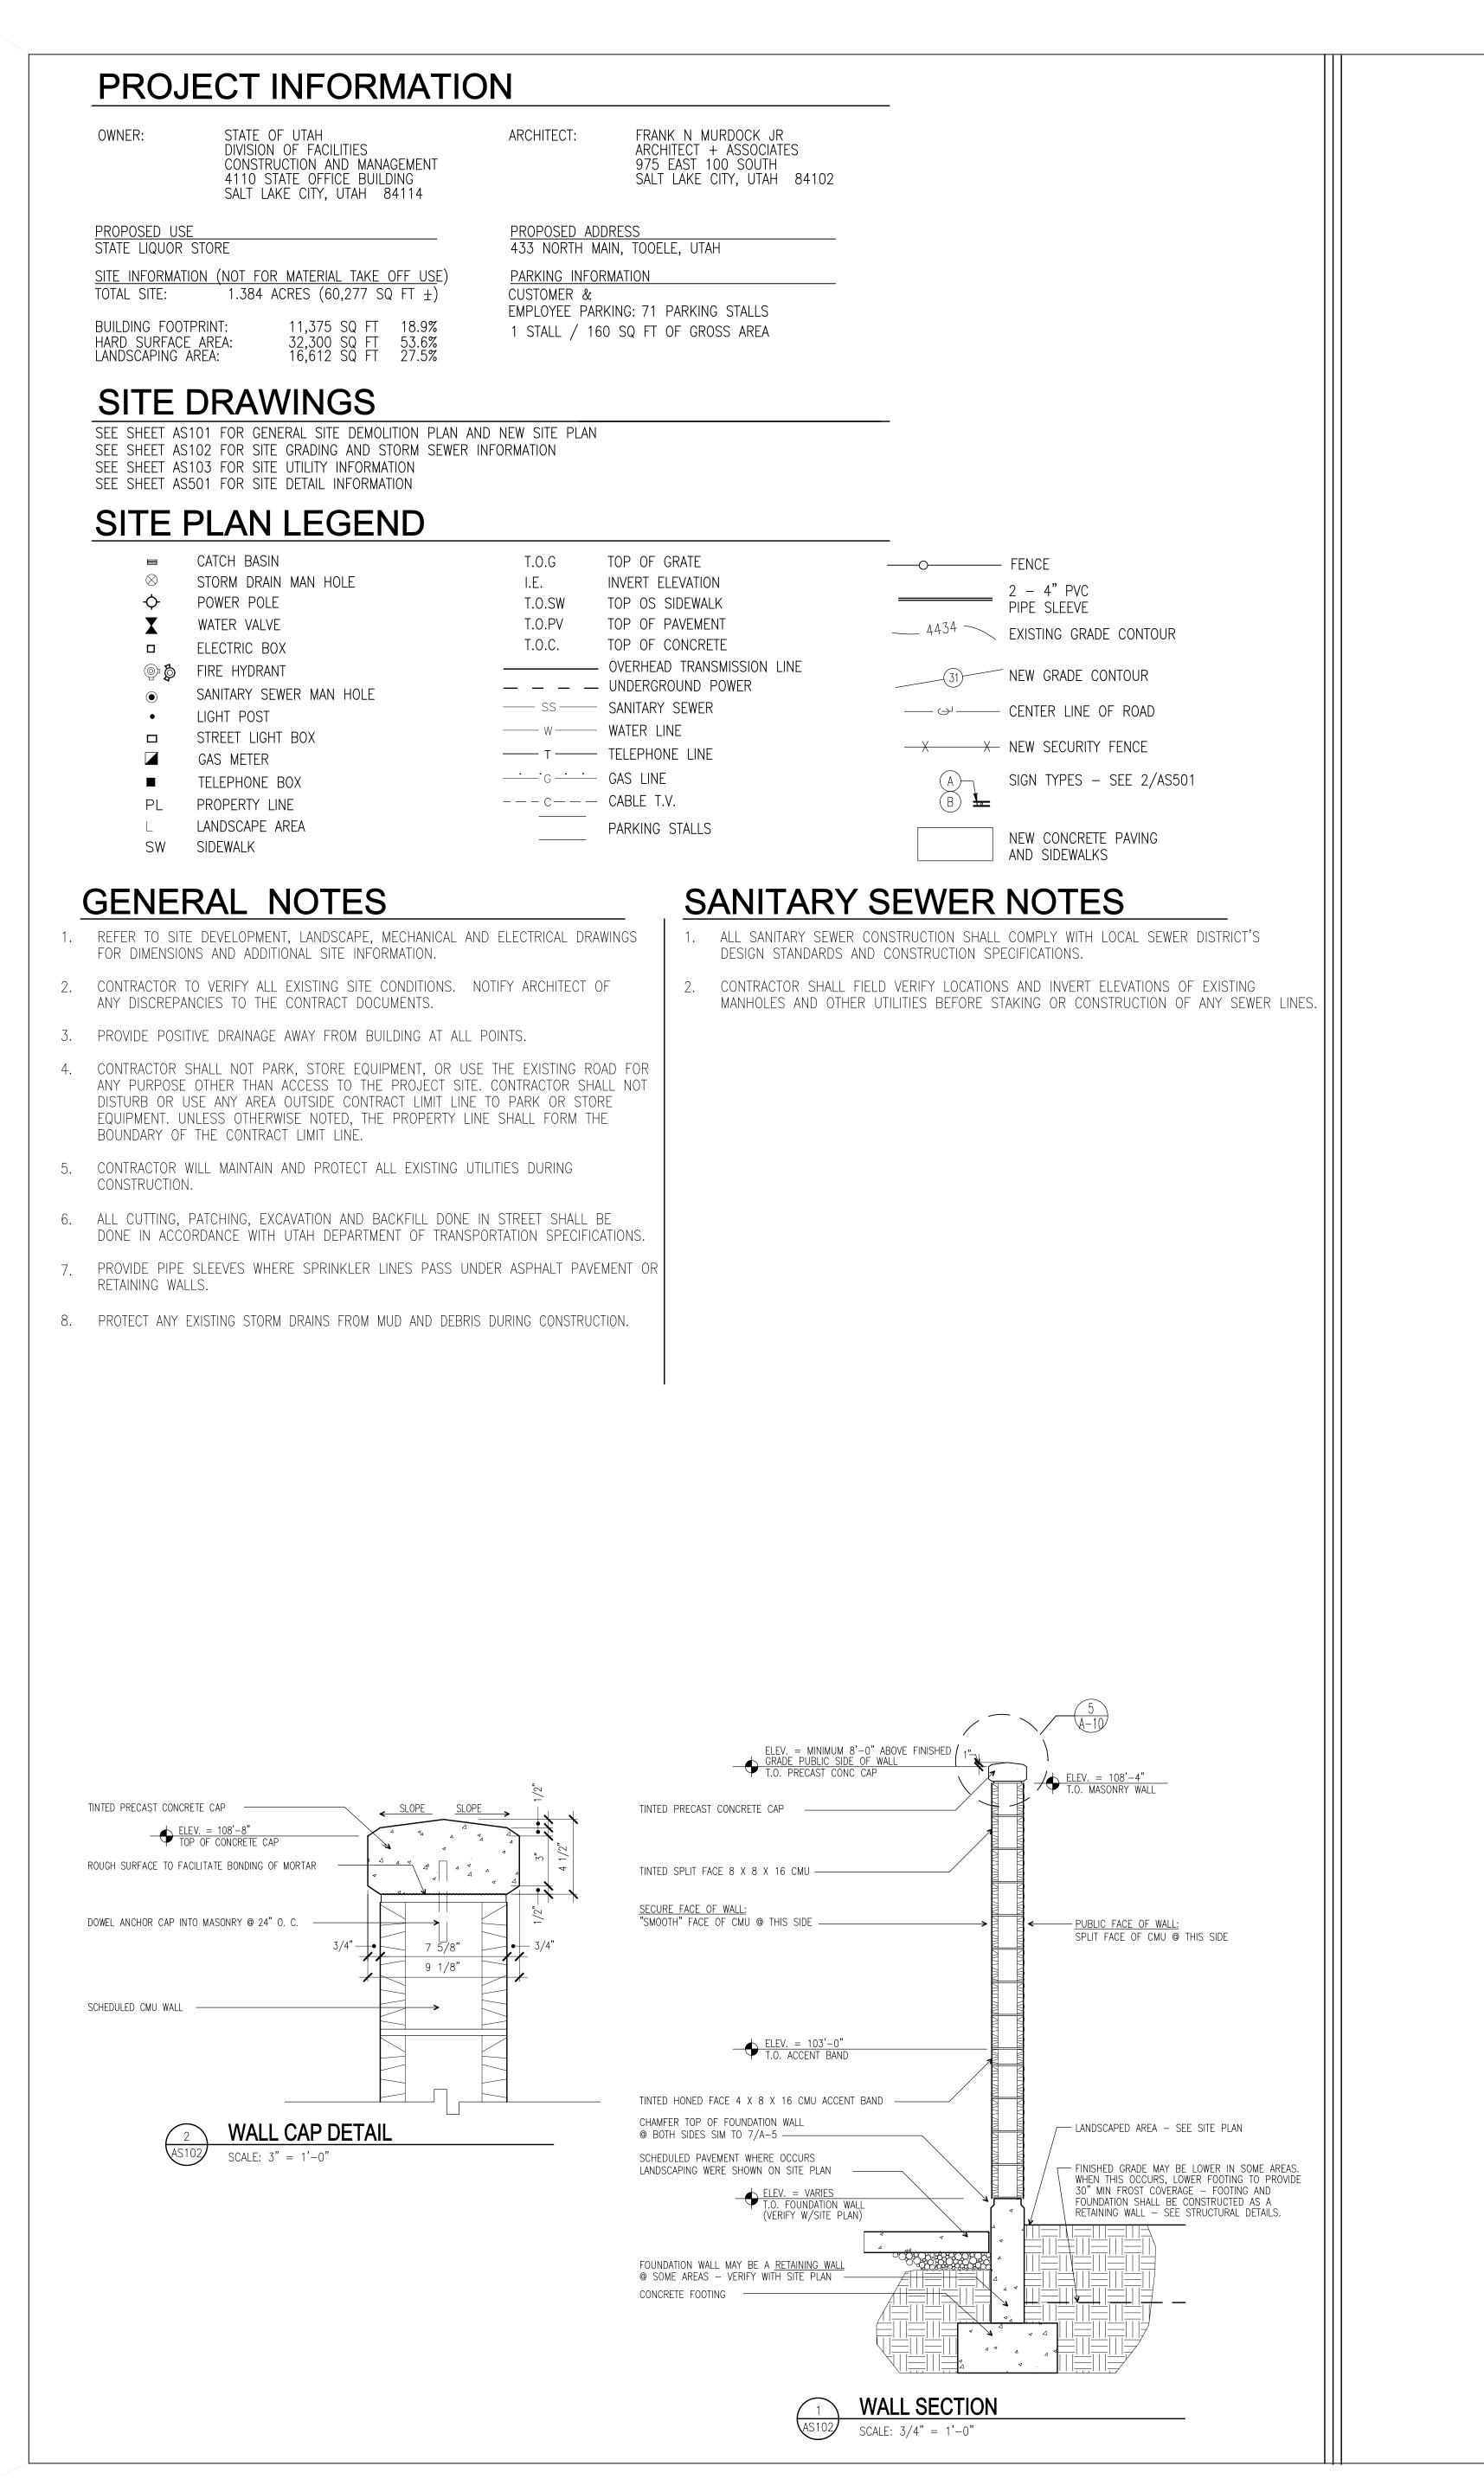

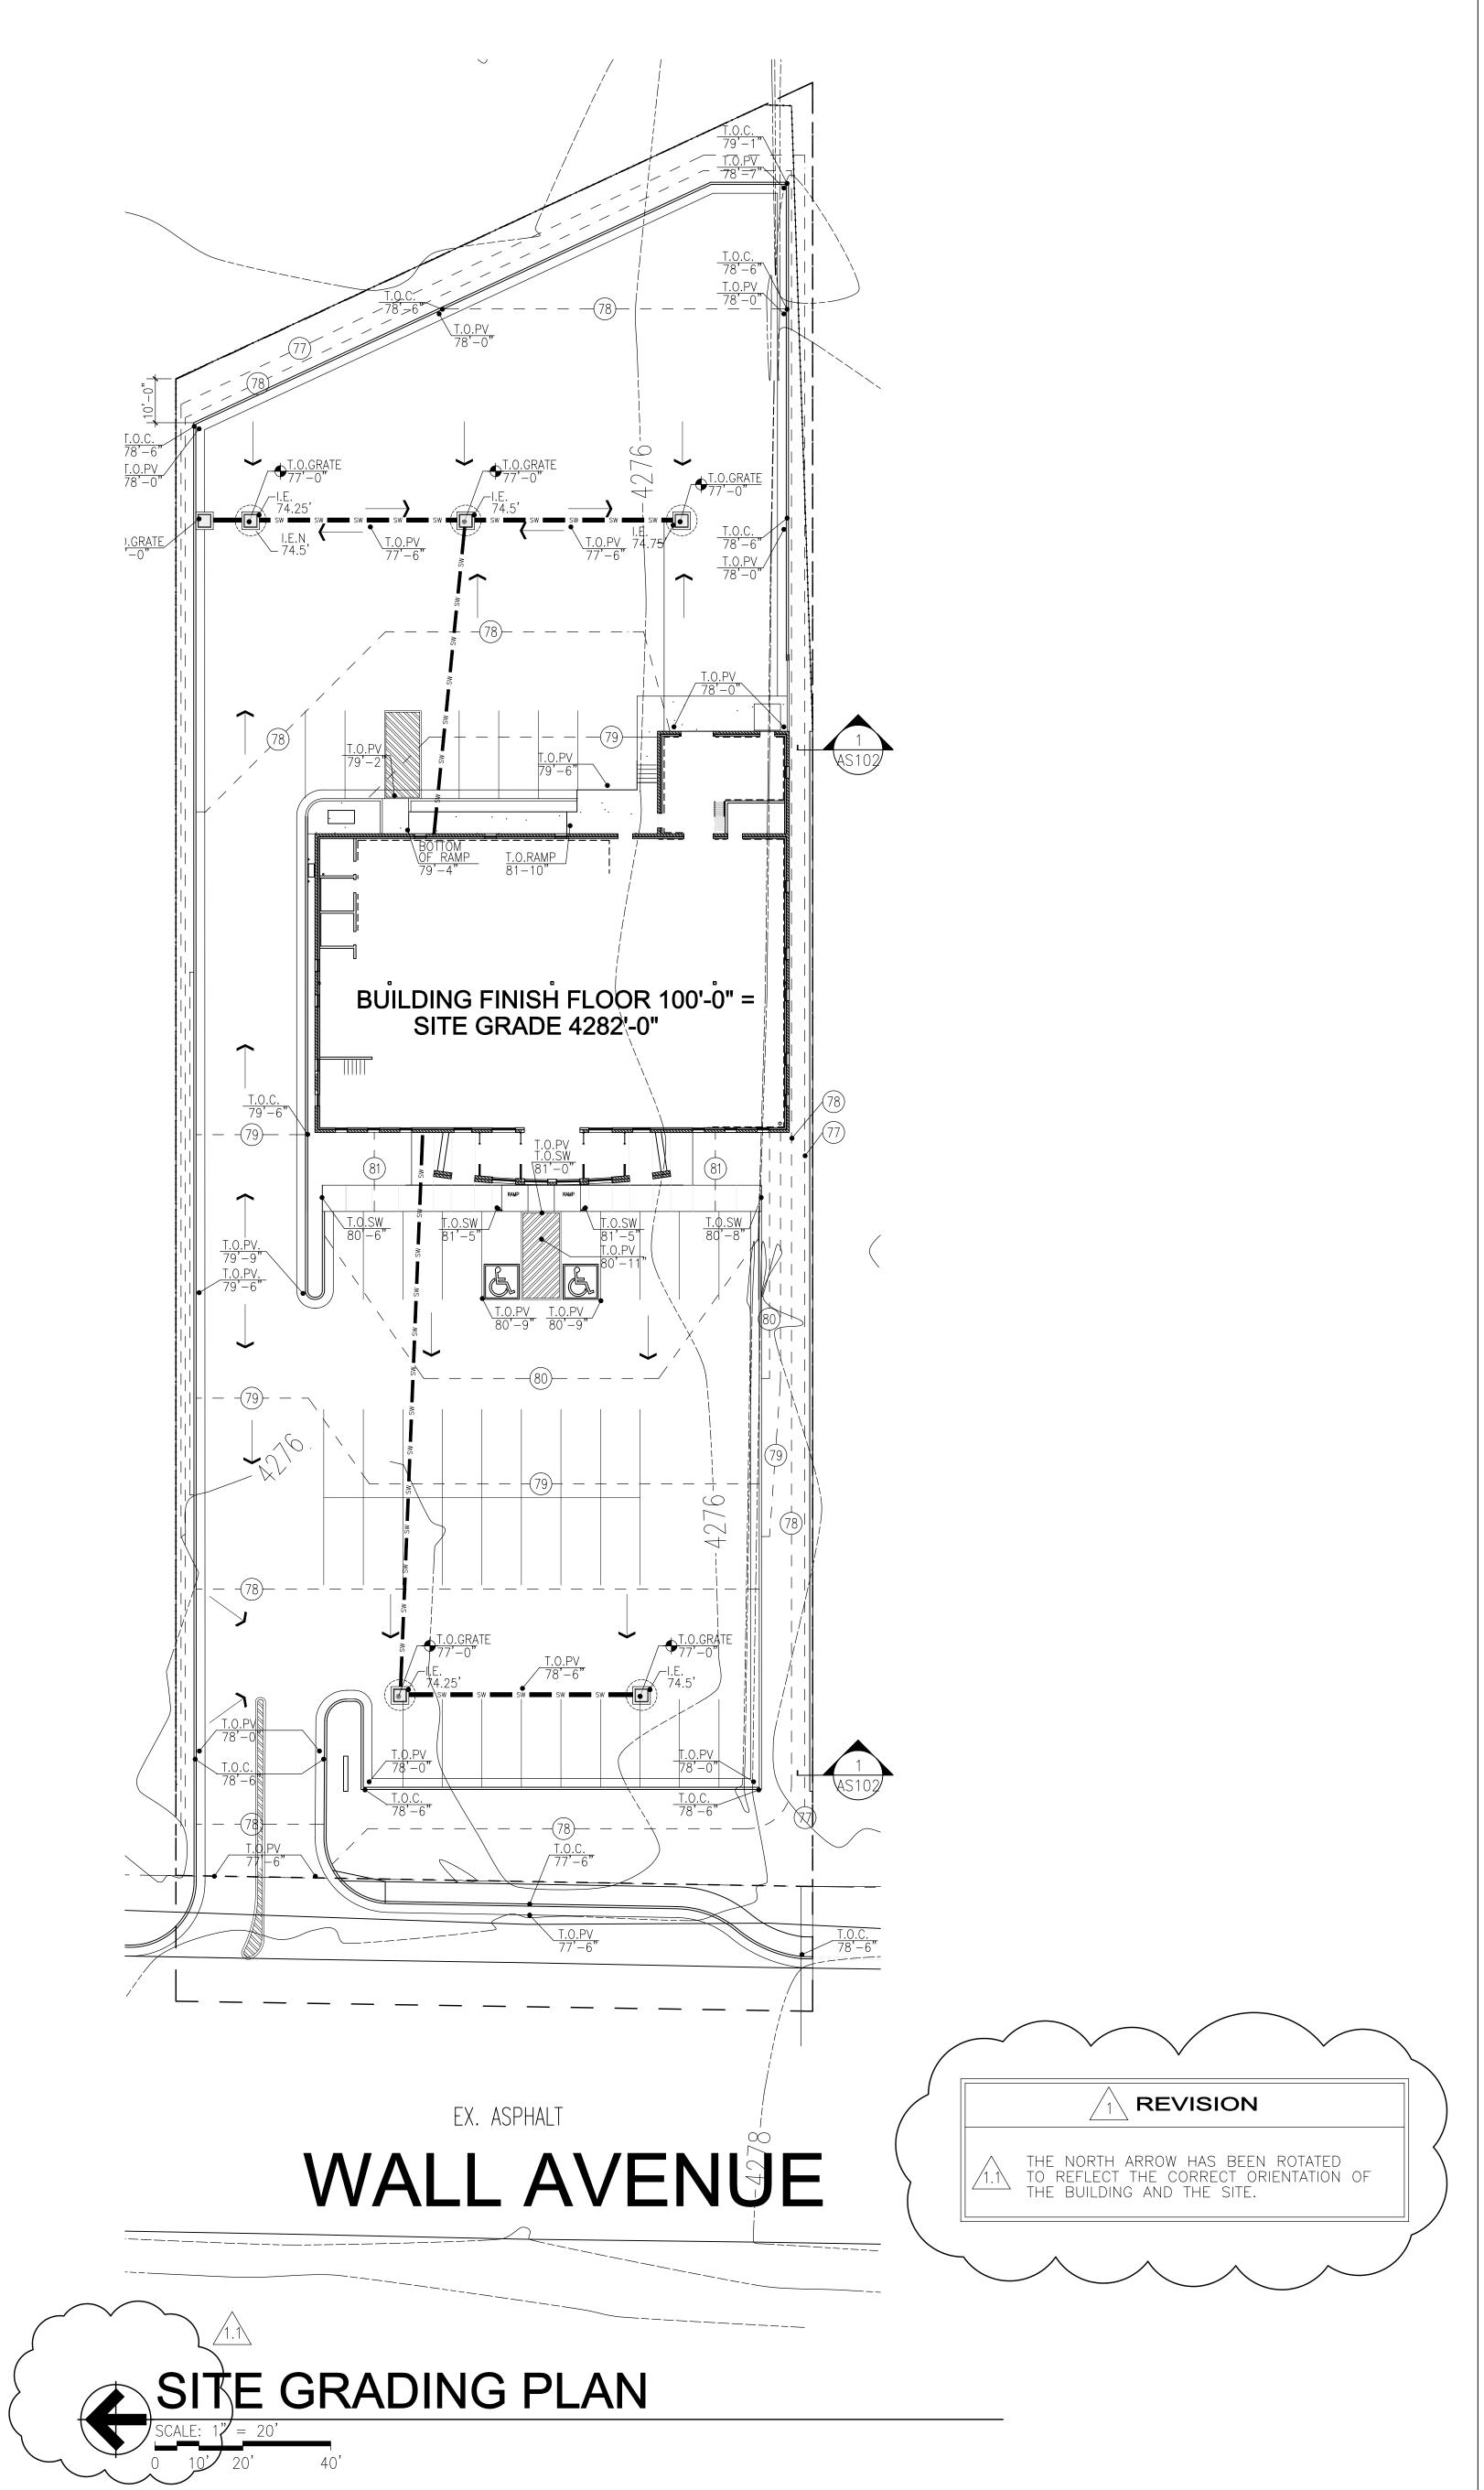


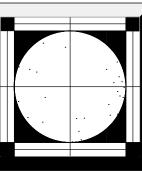

REVISION # DATE: <u>/1</u> 2/24/06

DFCM PROJECT NO .: 04242030 CONSTR. DOC. FILE NAME: ABCH-AS102 PLOT SCALE: 1:240 DRAWN BY: STAFF CHECKED BY: FNM DATE: JANUARY 24, 2006

AS

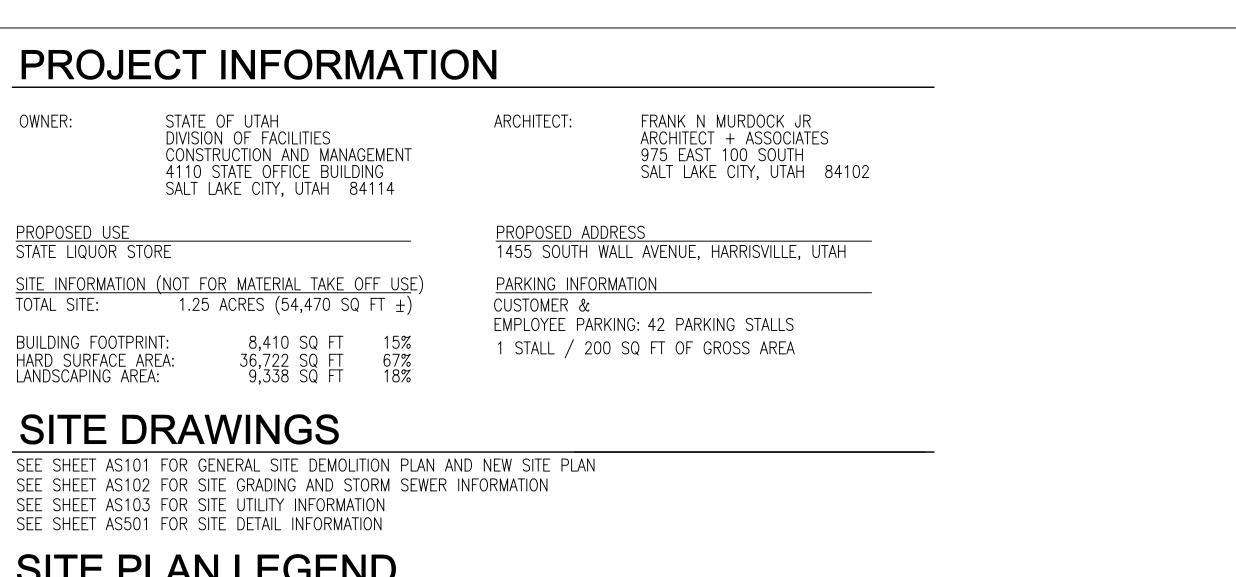

SITE PLAN LEGEND

| | CATCH BASIN | T.O.G | TOP OF GRATE | | - FENCE |
|--------------|-------------------------|----------|--|------------------|--------------------------------------|
| \otimes | STORM DRAIN MAN HOLE | I.E. | INVERT ELEVATION | | 2 - 4" PVC |
| ф | POWER POLE | T.O.SW | TOP OS SIDEWALK | | PIPE SLEEVE |
| X | WATER VALVE | T.O.PV | TOP OF PAVEMENT | 4434 | EXISTING GRADE CONTOUR |
| | ELECTRIC BOX | T.O.C. | TOP OF CONCRETE | | EXISTING GRADE CONTOUR |
| \$ | FIRE HYDRANT | | OVERHEAD TRANSMISSION LINEUNDERGROUND POWER | (31) | NEW GRADE CONTOUR |
| lacktriangle | SANITARY SEWER MAN HOLE | | - SANITARY SEWER | | OFNITED LINE OF DOAD |
| • | LIGHT POST | | | (-) | CENTER LINE OF ROAD |
| | STREET LIGHT BOX | ——— W——— | - WATER LINE | V V | NEW SECURITY FENCE |
| | GAS METER | —— T —— | - TELEPHONE LINE | $\overline{}$ | NEW SECONTT TENCE |
| | TELEPHONE BOX | —· | - GAS LINE | (A) | SIGN TYPES - SEE 2/AS501 |
| PL | PROPERTY LINE | c | - CABLE T.V. | B L | |
| L | LANDSCAPE AREA | | PARKING STALLS | | NEW CONCRETE DAVING |
| SW | SIDEWALK | | | | NEW CONCRETE PAVING AND SIDEWALKS |

GENERAL NOTES

- REFER TO SITE DEVELOPMENT, LANDSCAPE, MECHANICAL AND ELECTRICAL DRAWINGS FOR DIMENSIONS AND ADDITIONAL SITE INFORMATION.
- 2. CONTRACTOR TO VERIFY ALL EXISTING SITE CONDITIONS. NOTIFY ARCHITECT OF ANY DISCREPANCIES TO THE CONTRACT DOCUMENTS.
- ANY PURPOSE OTHER THAN ACCESS TO THE PROJECT SITE. CONTRACTOR SHALL NOT DISTURB OR USE ANY AREA OUTSIDE CONTRACT LIMIT LINE TO PARK OR STORE EQUIPMENT. UNLESS OTHERWISE NOTED, THE PROPERTY LINE SHALL FORM THE BOUNDARY OF THE CONTRACT LIMIT LINE.
- CONTRACTOR WILL MAINTAIN AND PROTECT ALL EXISTING UTILITIES DURING
- 6. ALL CUTTING, PATCHING, EXCAVATION AND BACKFILL DONE IN STREET SHALL BE DONE IN ACCORDANCE WITH UTAH DEPARTMENT OF TRANSPORTATION SPECIFICATIONS.
- PROVIDE PIPE SLEEVES WHERE SPRINKLER LINES PASS UNDER ASPHALT PAVEMENT OF RETAINING WALLS.
- 8. PROTECT ANY EXISTING STORM DRAINS FROM MUD AND DEBRIS DURING CONSTRUCTION.

UDOT NOTES

- The following UDOT Notes will be called out on the plan:
- a) Work on the UDOT right—of—way is restricted from October 15 through April 15.
- b) Any new pavement markings or pavement markings that are removed from the highway are to be replaced with in-kind materials such as 3M tape, epoxy, thermoplastic, etc. All paint lines are to be installed with permanent paint application before completion of the permit and must have at least 6 months life as determined by UDOT's permits officer.
- c) Before commencing work on the State highway, the contractor who is awarded the project must have a performance bond on file with UDOT, and obtain an encroachment permit from the Region Two Permits Office.
- d) Work is not allowed on the right—of—way during the AM/PM peak traffic hours (6:00-9:00 AM and 3:30-6:00 PM).

DEMOLITION AND SITE CLEARING

IT IS THE INTENT OF THIS PROJECT TO REMOVE AND PROPERLY DISPOSE OF ALL EXISTING IMPROVEMENTS ON THE PROPERTY. THE SITE SHOULD THEN BE GRUBBED IN ACCORDANCE WITH THE REQUIREMENTS OF THE SOILS REPORT AND PREPARED FOR NEW CONSTRUCTION.

REFERENCE NOTES

- REMOVE AND PROPERLY DISPOSE OF EXISTING BUILDING INCLUDING ALL FOOTINGS, FOUNDATIONS, AND ASSOCIATED UNDERGROUND CONCRETE.
- < $_{
 m 2}$ > REMOVE AND PROPERLY DISPOSE OF EXISTING LANDSCAPING INCLUDING ALL TREES AND SHRUBS ON SITE. SEE SOILS REPORT FOR THE DEPTH OF GRUBBING IN THIS AREA.

 AND SHRUBS ON SITE. SEE SOILS REPORT FOR THE DEPTH OF GRUBBING IN THIS AREA.


3 REMOVE AND PROPERLY DISPOSE OF EXISTING CONCRETE SIDEWALK OR PAD.


- REMOVE AND PROPERLY DISPOSE OF ALL EXISTING ASPHALT CONCRETE PAVING. ON SITE.
- 5 CAP EXISTING WATER LINE AT THE EXISTING METER OR AS DIRECTED BY SERVICE PROVIDER. COORDINATE THE REMOVAL OF EXISTING METERS WITH THE
- <6> CAP EXISTING SANITARY SEWER LINE AT THE MAIN LINE OR AS DIRECTED BY


 $\stackrel{\textstyle <}{\textstyle \sim}$ Cap existing natural gas line at the main line or as directed by

- SERVICE PROVIDER. COORDINATE THE REMOVAL OF EXISTING METERS WITH THE REMOVE AND PROPERLY DISPOSE OF ALL EXISTING ELECTRICAL LINES AND ASSOCIATED SITE LIGHTING, PANELS AND METERS LOCATED ON SITE WHICH ARE NOT USED AS PART
- OF THIS PROJECT AND WHICH DO NOT PROVIDE SERVICE TO ADJACENT PROPERTIES. SEE ELECTRICAL DRAWINGS FOR NEW SERVICE CONNECTION AND LOCATION. REMOVE AND PROPERLY DISPOSE OF EXISTING WOOD OR CHAIN LINK FENCE.
- MAINTAIN AND PROTECT EXISTING FENCES AT THE PROPERTY LINES UNTIL NEW ARE INSTALLED.

- MAINTAIN AND PROTECT EXISTING SITE ELEMENTS TO REMAIN INCLUDING EXISTING RETAINING WALLS, FENCES, STORM DRAIN BASIN AND CURBS AND GUTTERS.
- B NEW CONCRETE CURB & GUTTER. SEE DETAIL 6/AS501
- > NEW 4" THICK CONCRETE SIDEWALK. SEE DETAILS 11, 12 & 13 SHEET AS501 ALIGN WITH EDGES AND ELEVATIONS OF EXISTING SIDEWALKS WHERE NEW AND OLD SIDEWALKS MEET. JOINTS AS NOTED BELOW TYPICAL UNLESS NOTED OTHERWISE
- D NEW ASPHALT CONCRETE PAVING. SEE DETAIL 10/AS501 FOR PAVEMENT SECTION. SEE SOILS REPORT FOR DEPTH OF FILL AND COMPACTION REQUIREMENTS IN THIS AREA.
- NEW OPEN CONCRETE DRIVEWAY TO COMPLY WITH UTAH DEPARTMENT OF TRANSPIRATION STANDARDS — STANDARD DRAWING GW 4.
- F NEW DRY SUMP CATCH BASIN SEE DETAIL 2/AS103
- G NEW PARKING STRIPING SEE DETAIL 3/AS501
- THE EXISTING FENCE ON THE SOUTH PROPERTY LINE.
- ALIGN WITH EDGES AND ELEVATIONS OF EXISTING ASPHALT ROADWAY. WHERE NEW AND OLD ASPHALT MEET. MATCH ELEVATION AND FLOW LINE OF EXISTING ASPHALT.
- < L > NEW $\,$ 8" THICK CONCRETE DRIVE OR APRON. SEE 5/AS501. CONCRETE AT APRONS AND DRIVES (INCLUDING SIDEWALK AT DRIVE) TO BE MINIMUM 8" THICK.
- M NEW CONCRETE SPLASH BLOCK.
- < N > NEW LANDSCAPE AREA SEE SHEET LS-101
- < 0 > PROVIDE AND INSTALL NEW FIRE HYDRANT PER HARRISVILLE CITY STANDARDS COORDINATE CONNECTION OF NEW 6" WATER LINE TO EXISTING 6" LINE WITH UTILITY COMPANY.
- < P > PROVIDE AND INSTALL DUMPSTER ENCLOSURE, 6' HIGH CHAIN LINK FENCE, WITH TWO 6' HIGH HINGED GATES, WITH VERTICAL SCREENING SLATS IN FENCE AND GATES.
- Q MONUMENT SIGN BY OWNER. ELECTRICAL SERVICE PROVIDED UNDER THIS CONTRACT
- < R > PROVIDE AND INSTALL 145' OF SIDEWALK 5' WIDE X 4" THICK EXACT LOCATION AS DRECTED BY UDOT & HARRISVILLE CITY
- < S > SAW CUT EXISTING ASPHALT MIN 24" BACK FROM EXISTING EDGES. FEATHER NEW ASPHALT INTO EXISTING PER UDOT STANDARDS. ALL ASPHALT WORK AT EXISTING ROAD IS TO BE INSTALLED PER UDOT STANDARDS.

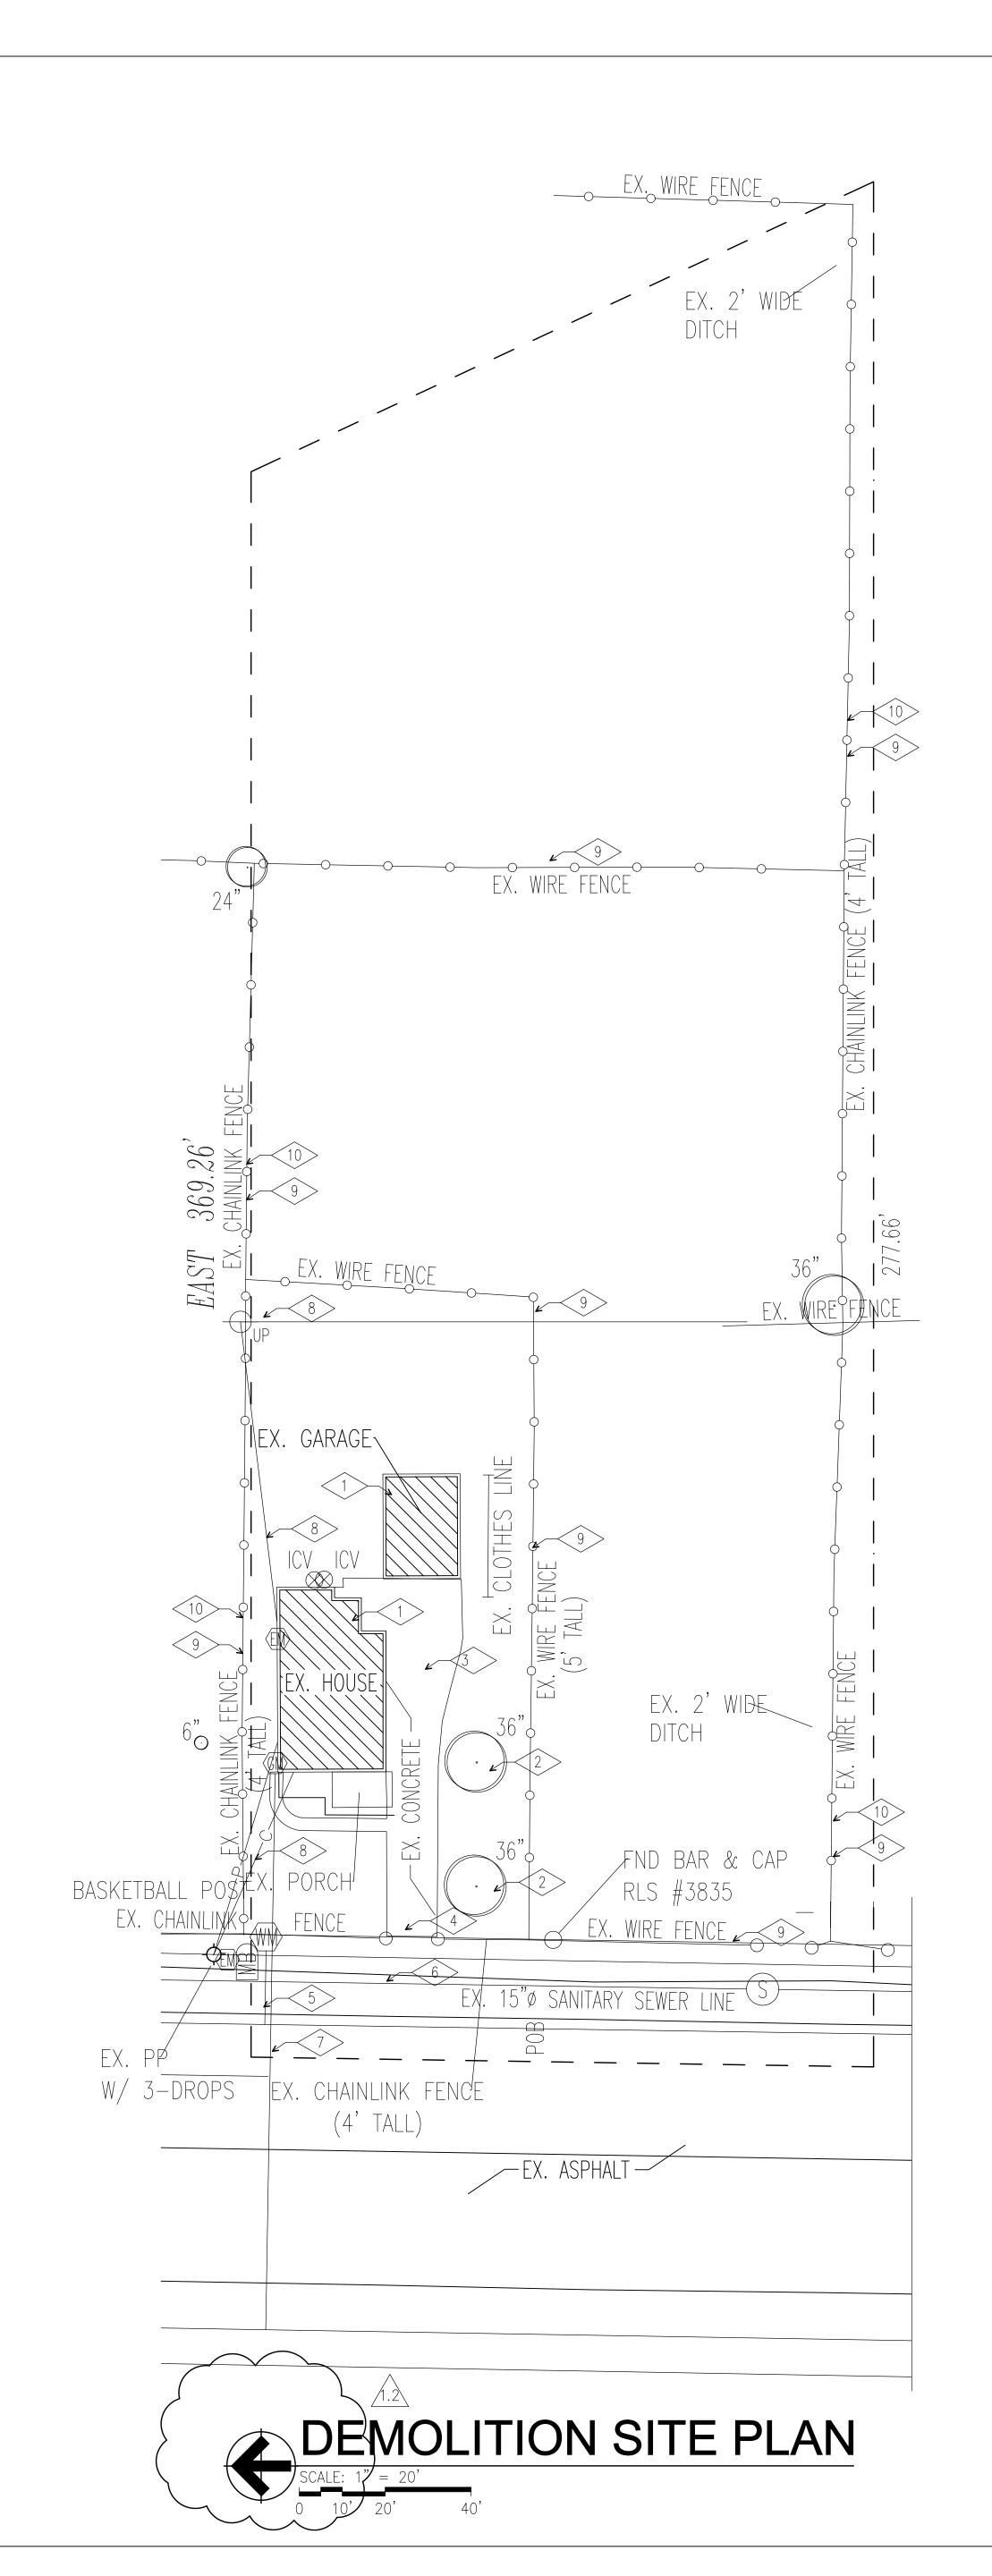


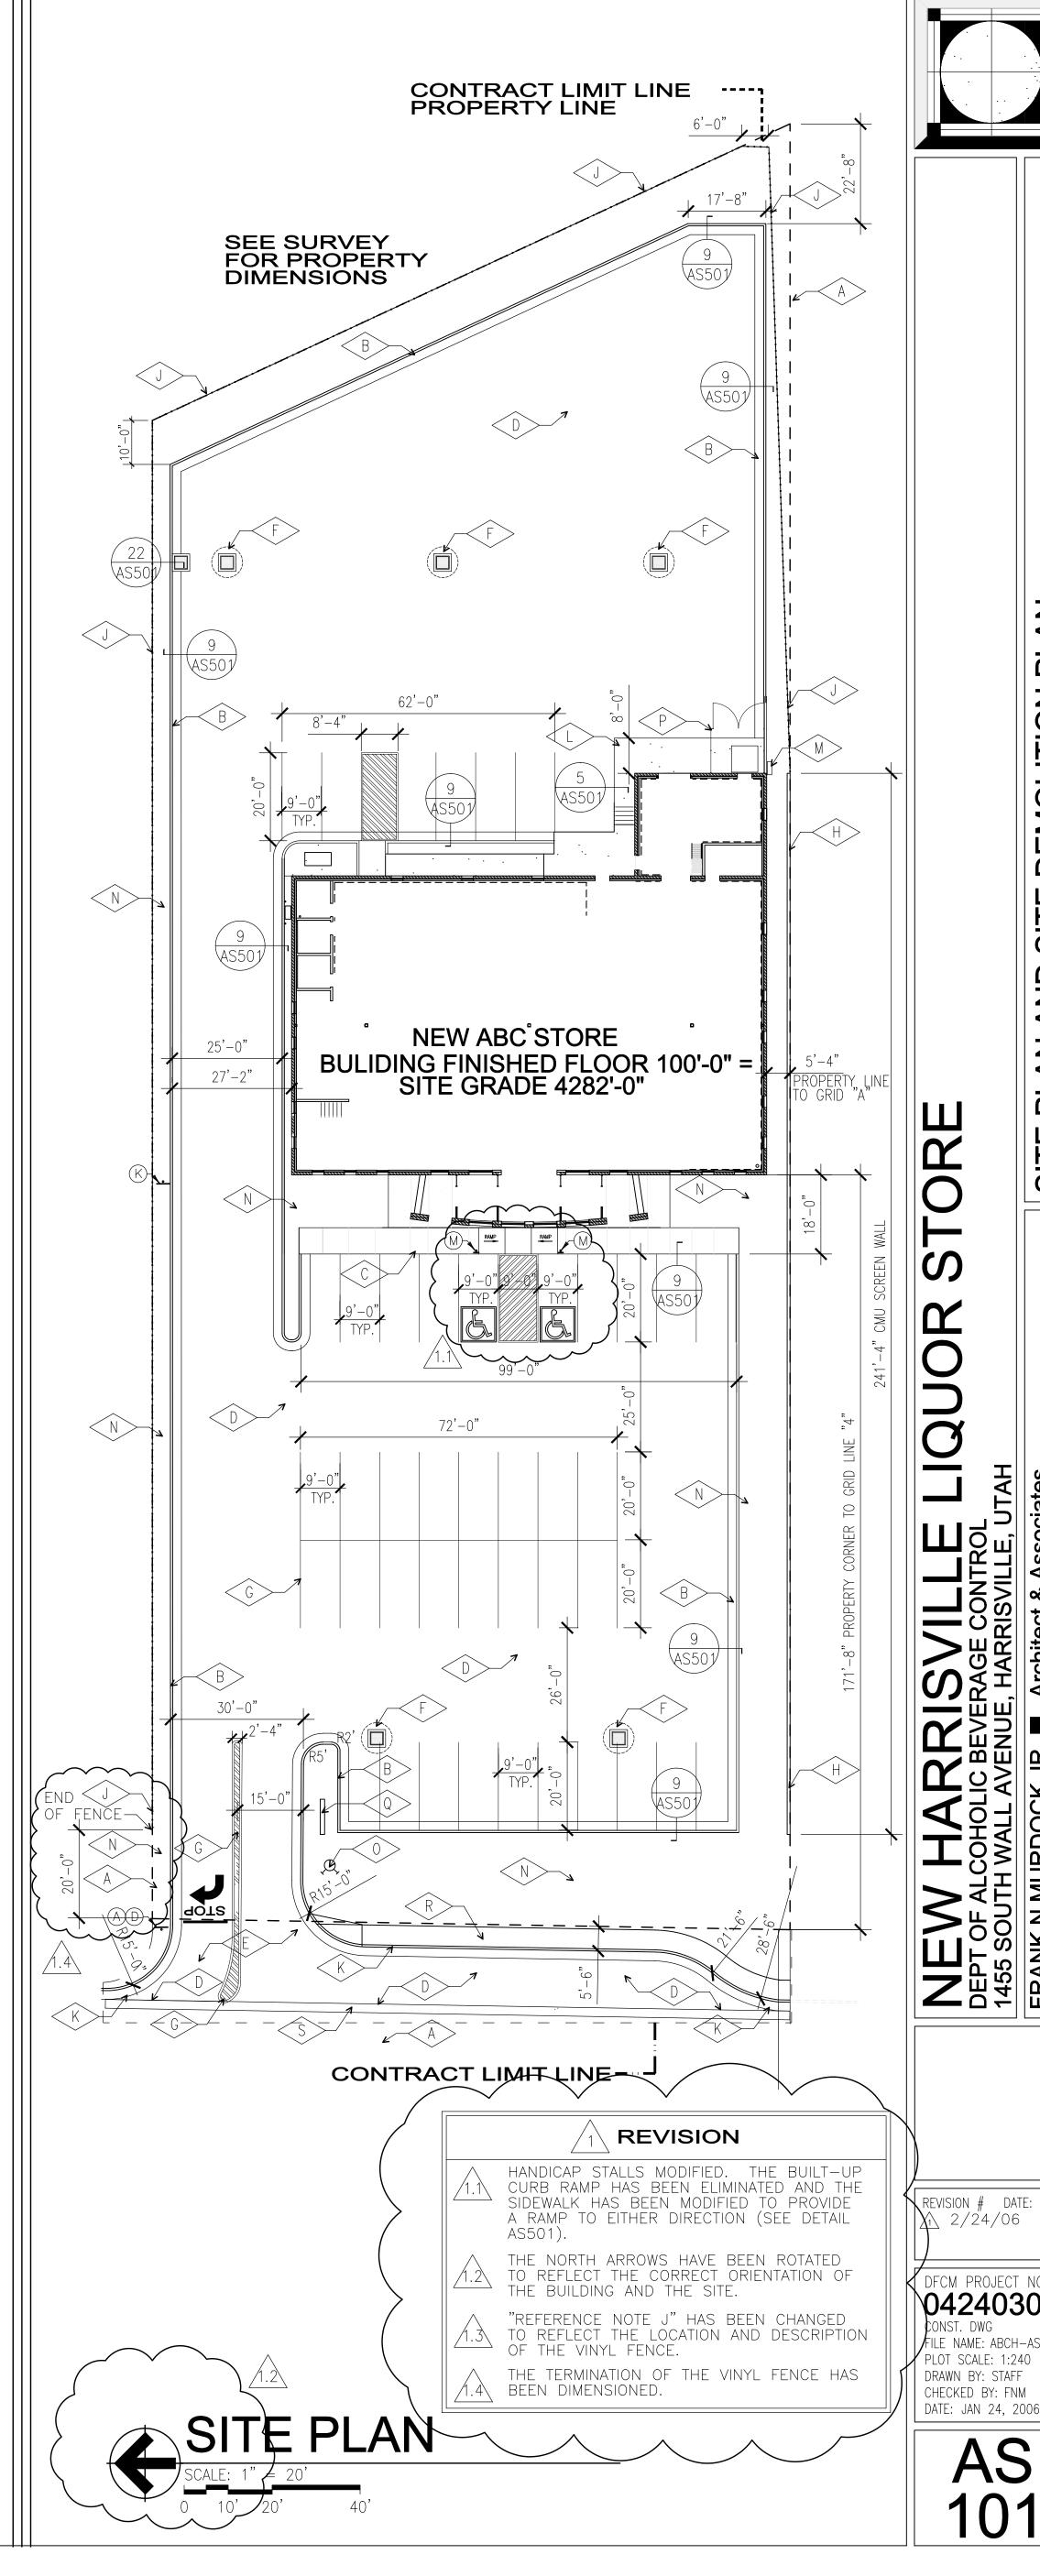

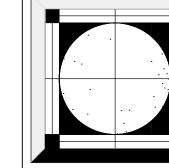


DFCM PROJECT NO. 0424030 CONST. DWG FILE NAME: ABCH-AS101 PLOT SCALE: 1:240

CHECKED BY: FNM DATE: JAN 24, 2006 AS

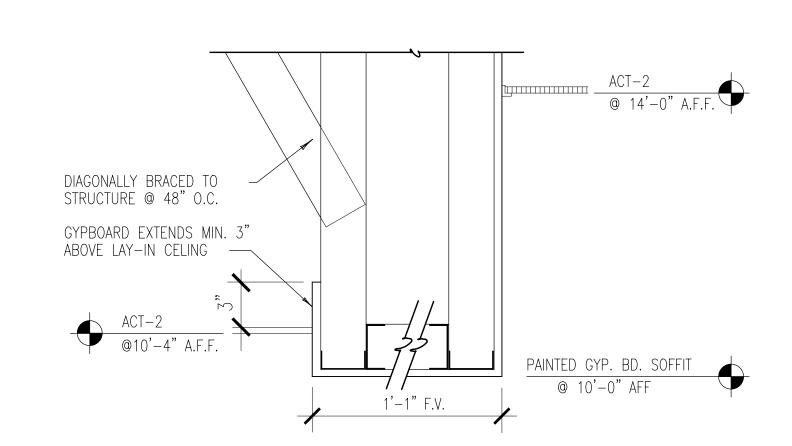







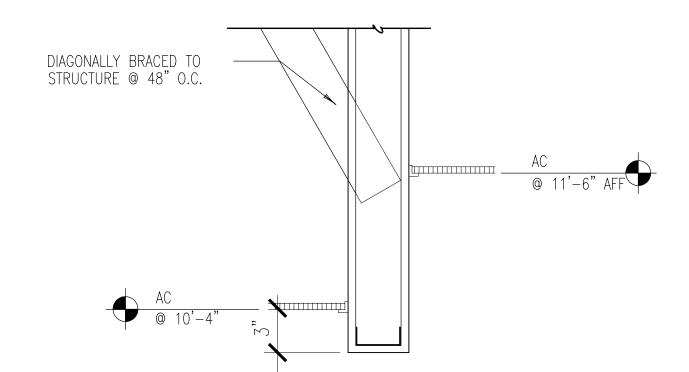


CEILING DROP DETAIL A102 | SCALE: NOT TO SCALE

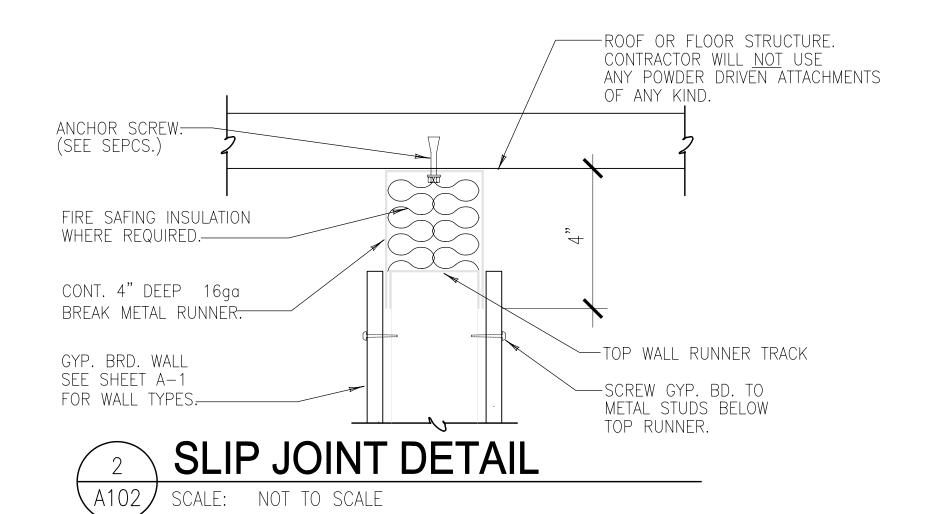

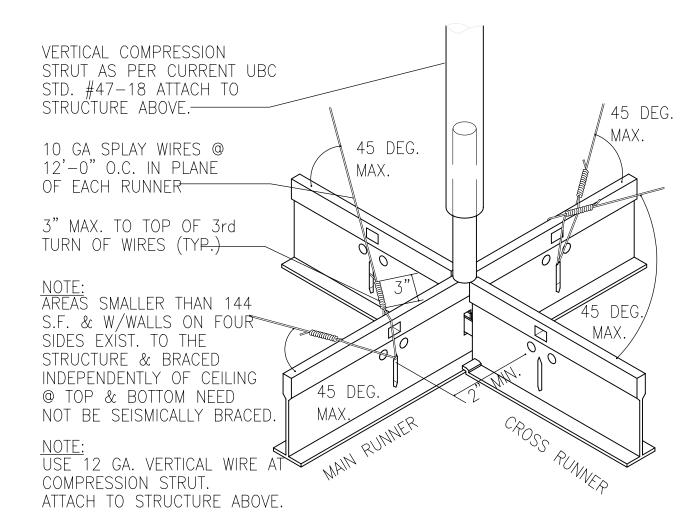



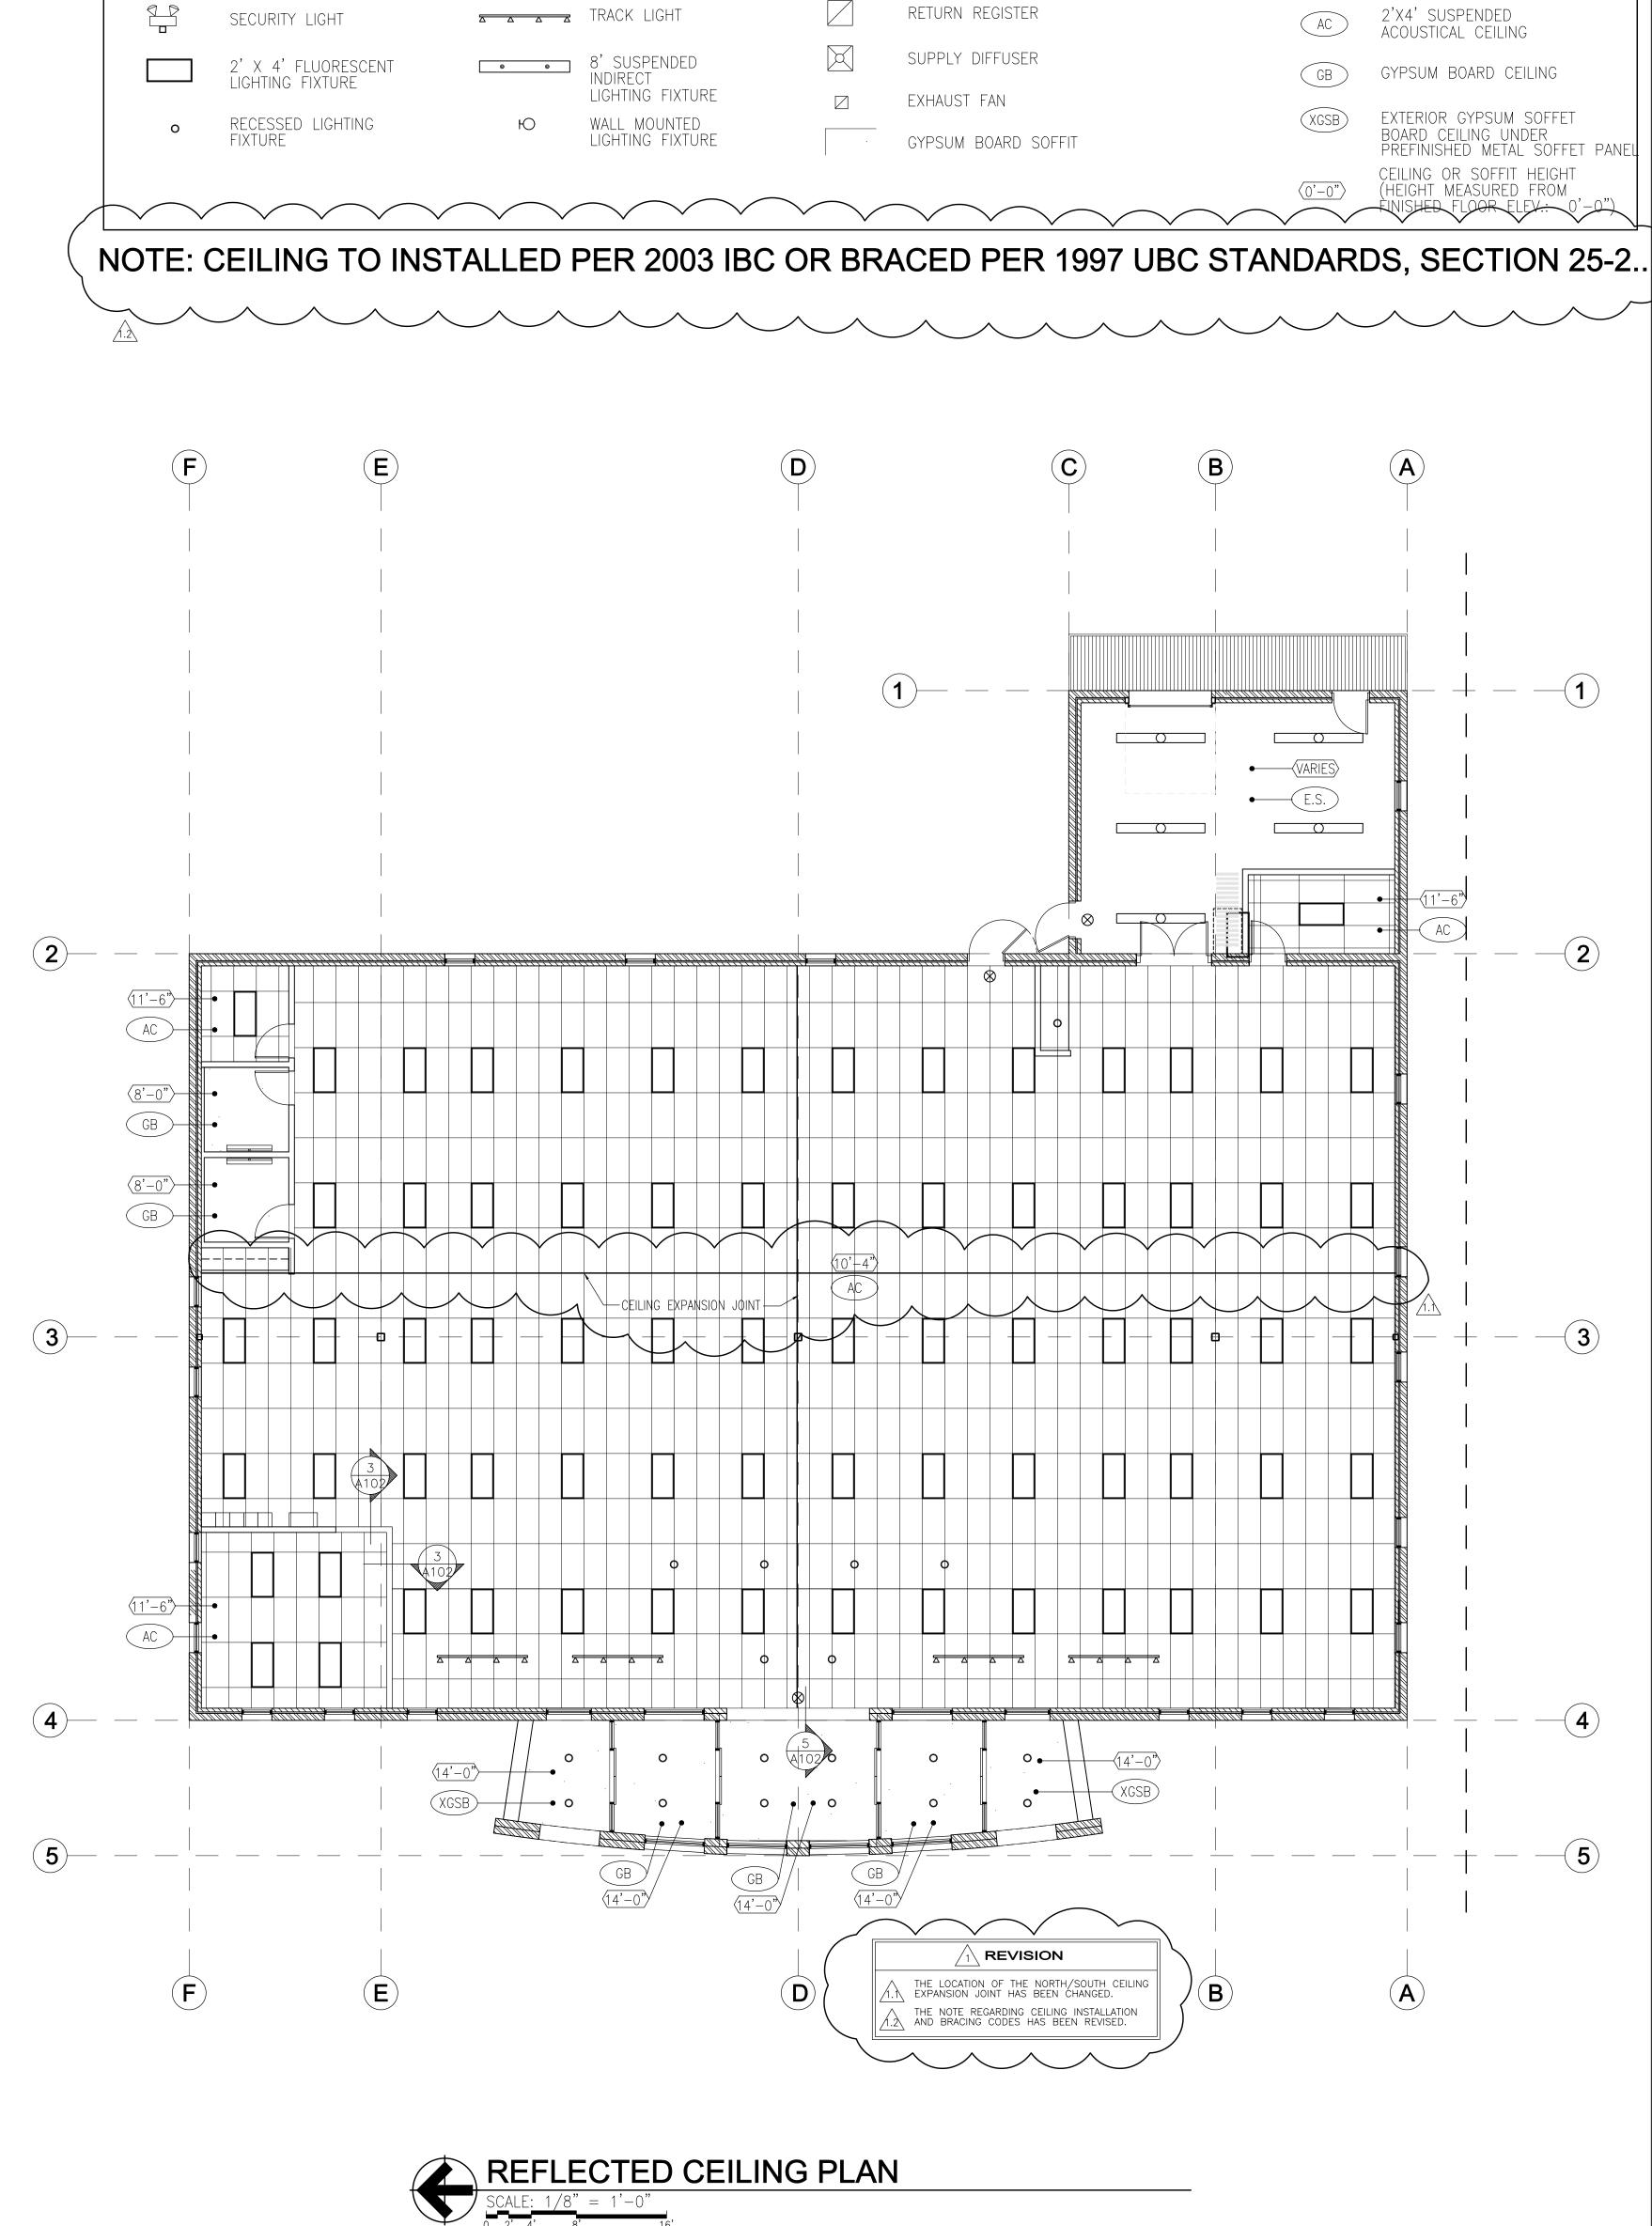

2'X4' SUSPENDED ACOUSTICAL CEILING PROVIDE SEISMIC BRACING — SEE 1/A102

METAL SOFFIT PANEL

REFLECTED CEILING PLAN LEGEND

8' SUSPENDED LIGHTING FIXTURE

UNIT HEATER

4' WALL MOUNTED LIGHTING FIXTURE

2' SURFACE MOUNTED LIGHTING FIXTURE


E.S. PAINTED EXPOSED STRUCTURE HEIGHT MAY VARY


MSP METAL SOFFIT PANEL

CEILING

REVISION # DATE: <u>/1.1</u> 2/24/06

DFCM PROJECT NO .: 04242030 CONSTR. DOC. FILE NAME: ABCH-A102 PLOT SCALE: 1:64 DRAWN BY: STAFF CHECKED BY: FNM DATE: JANUARY 24, 2006

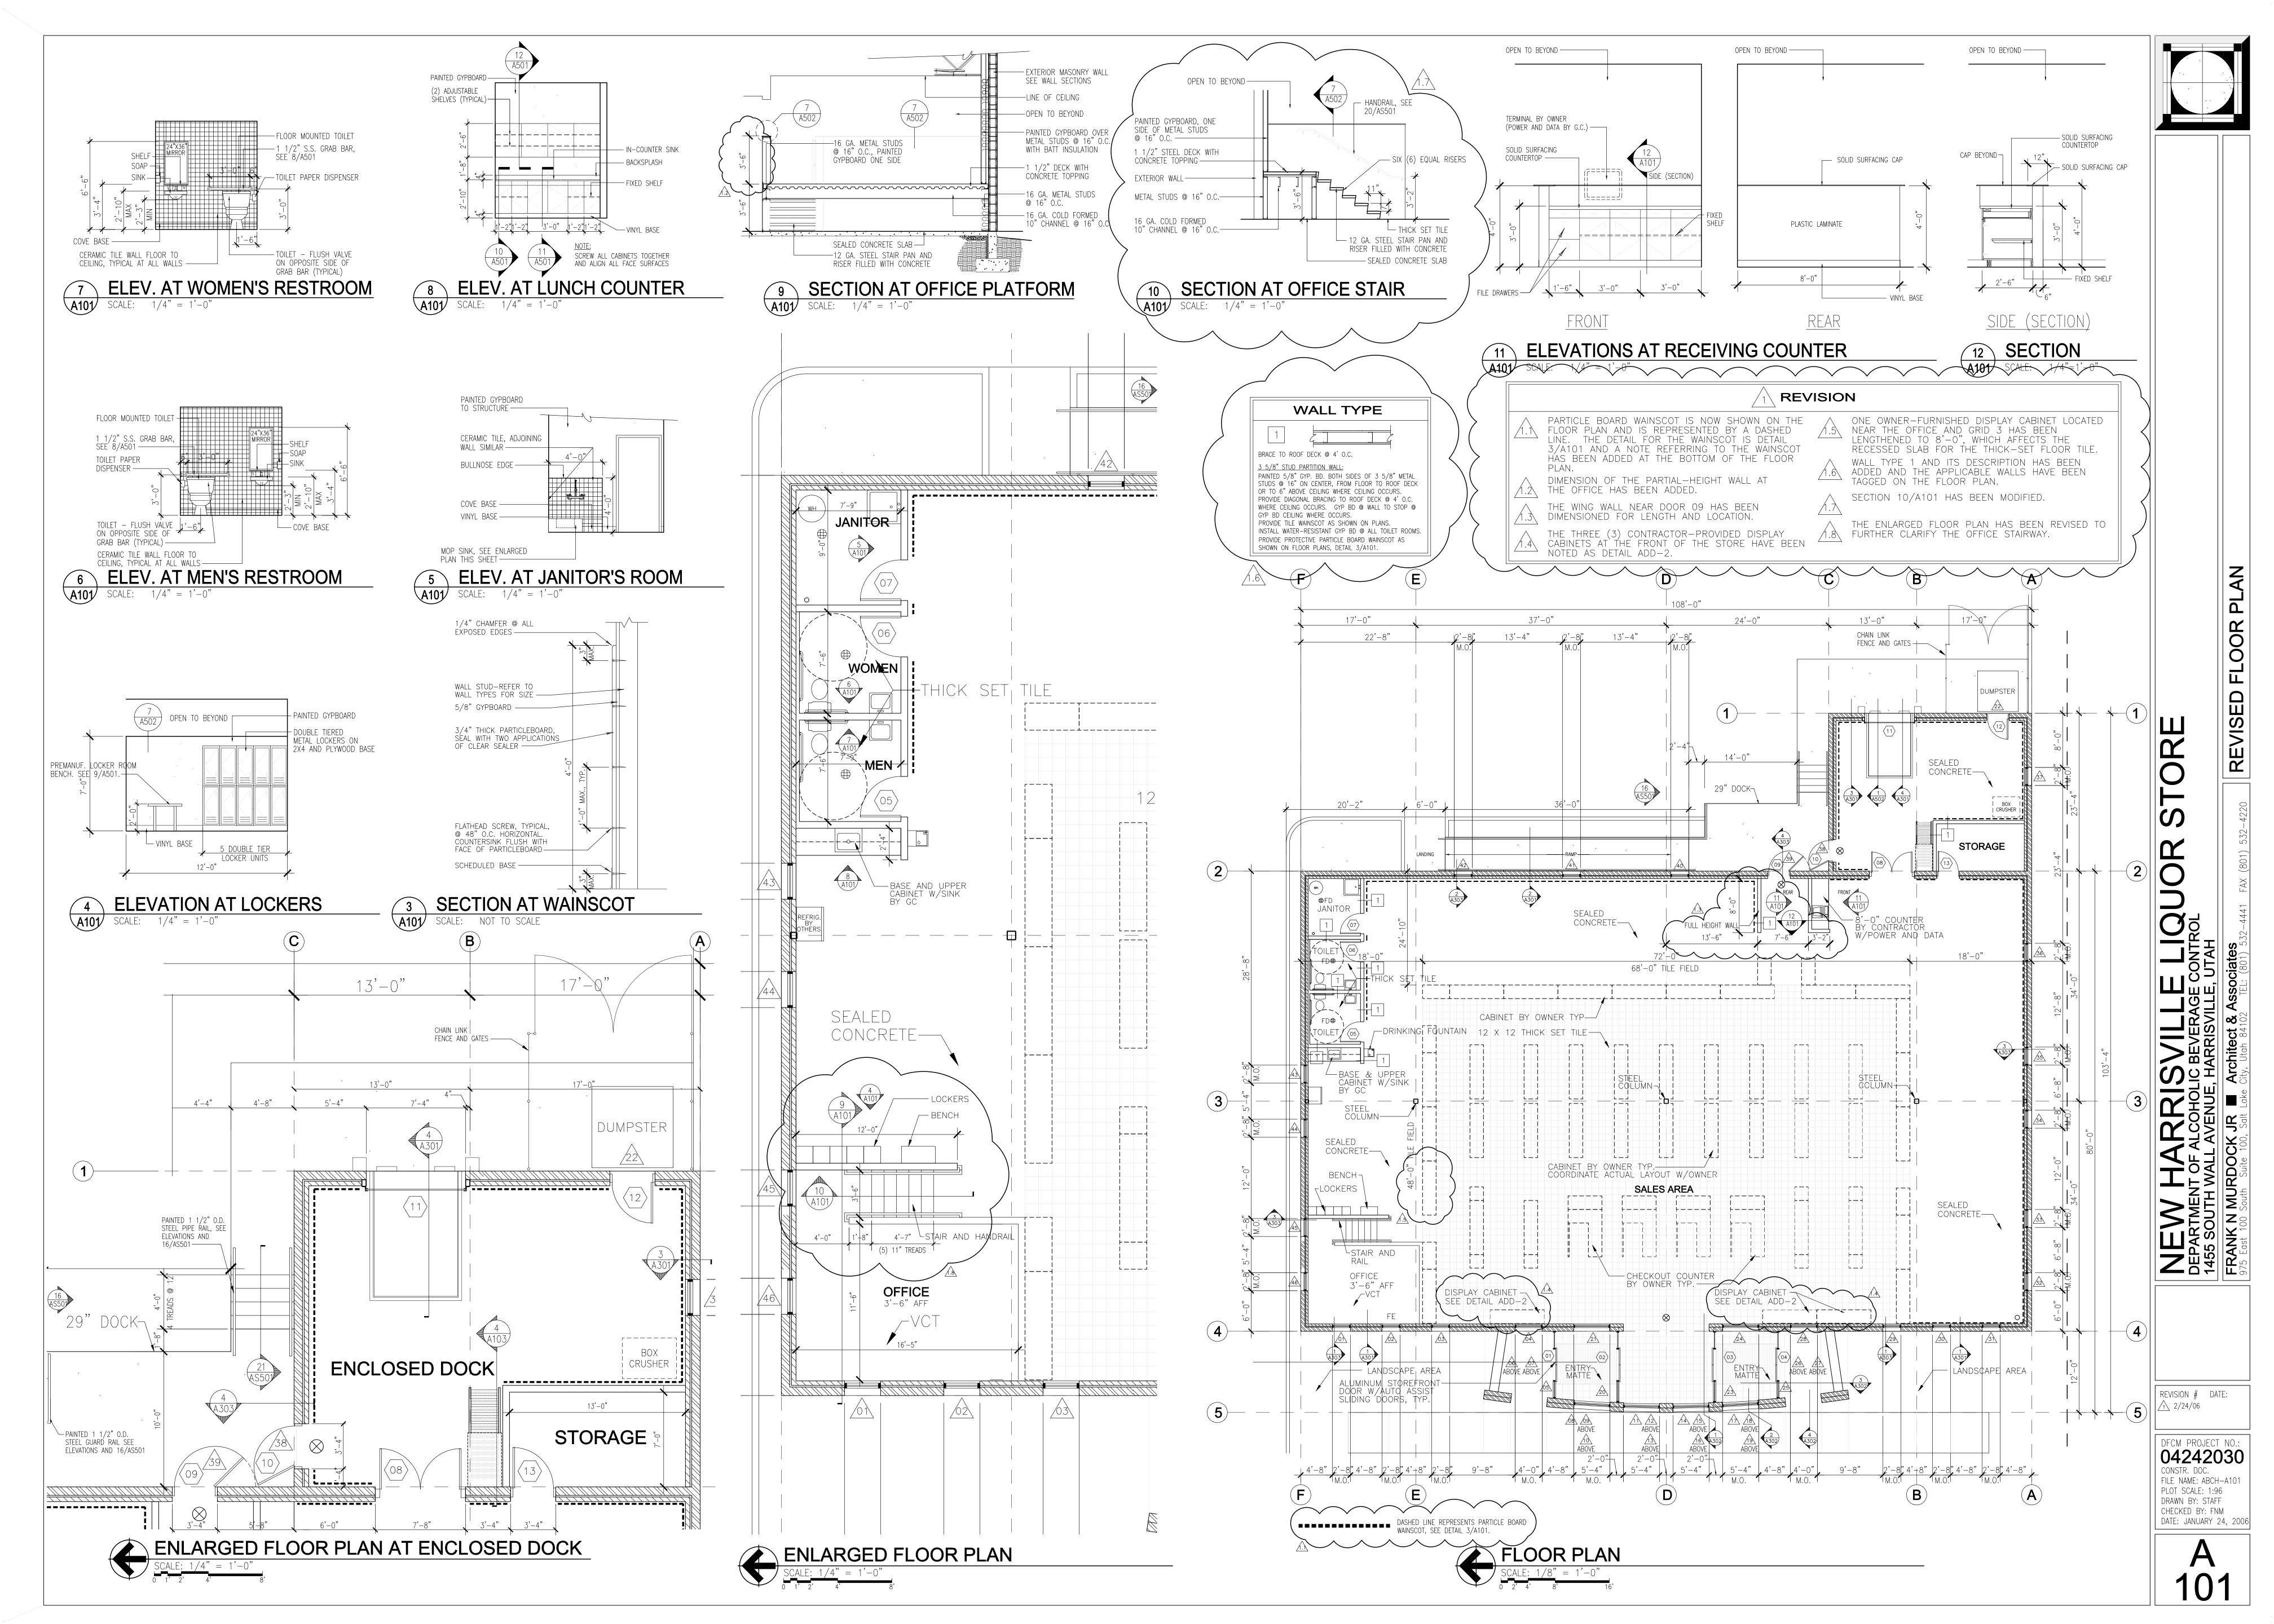

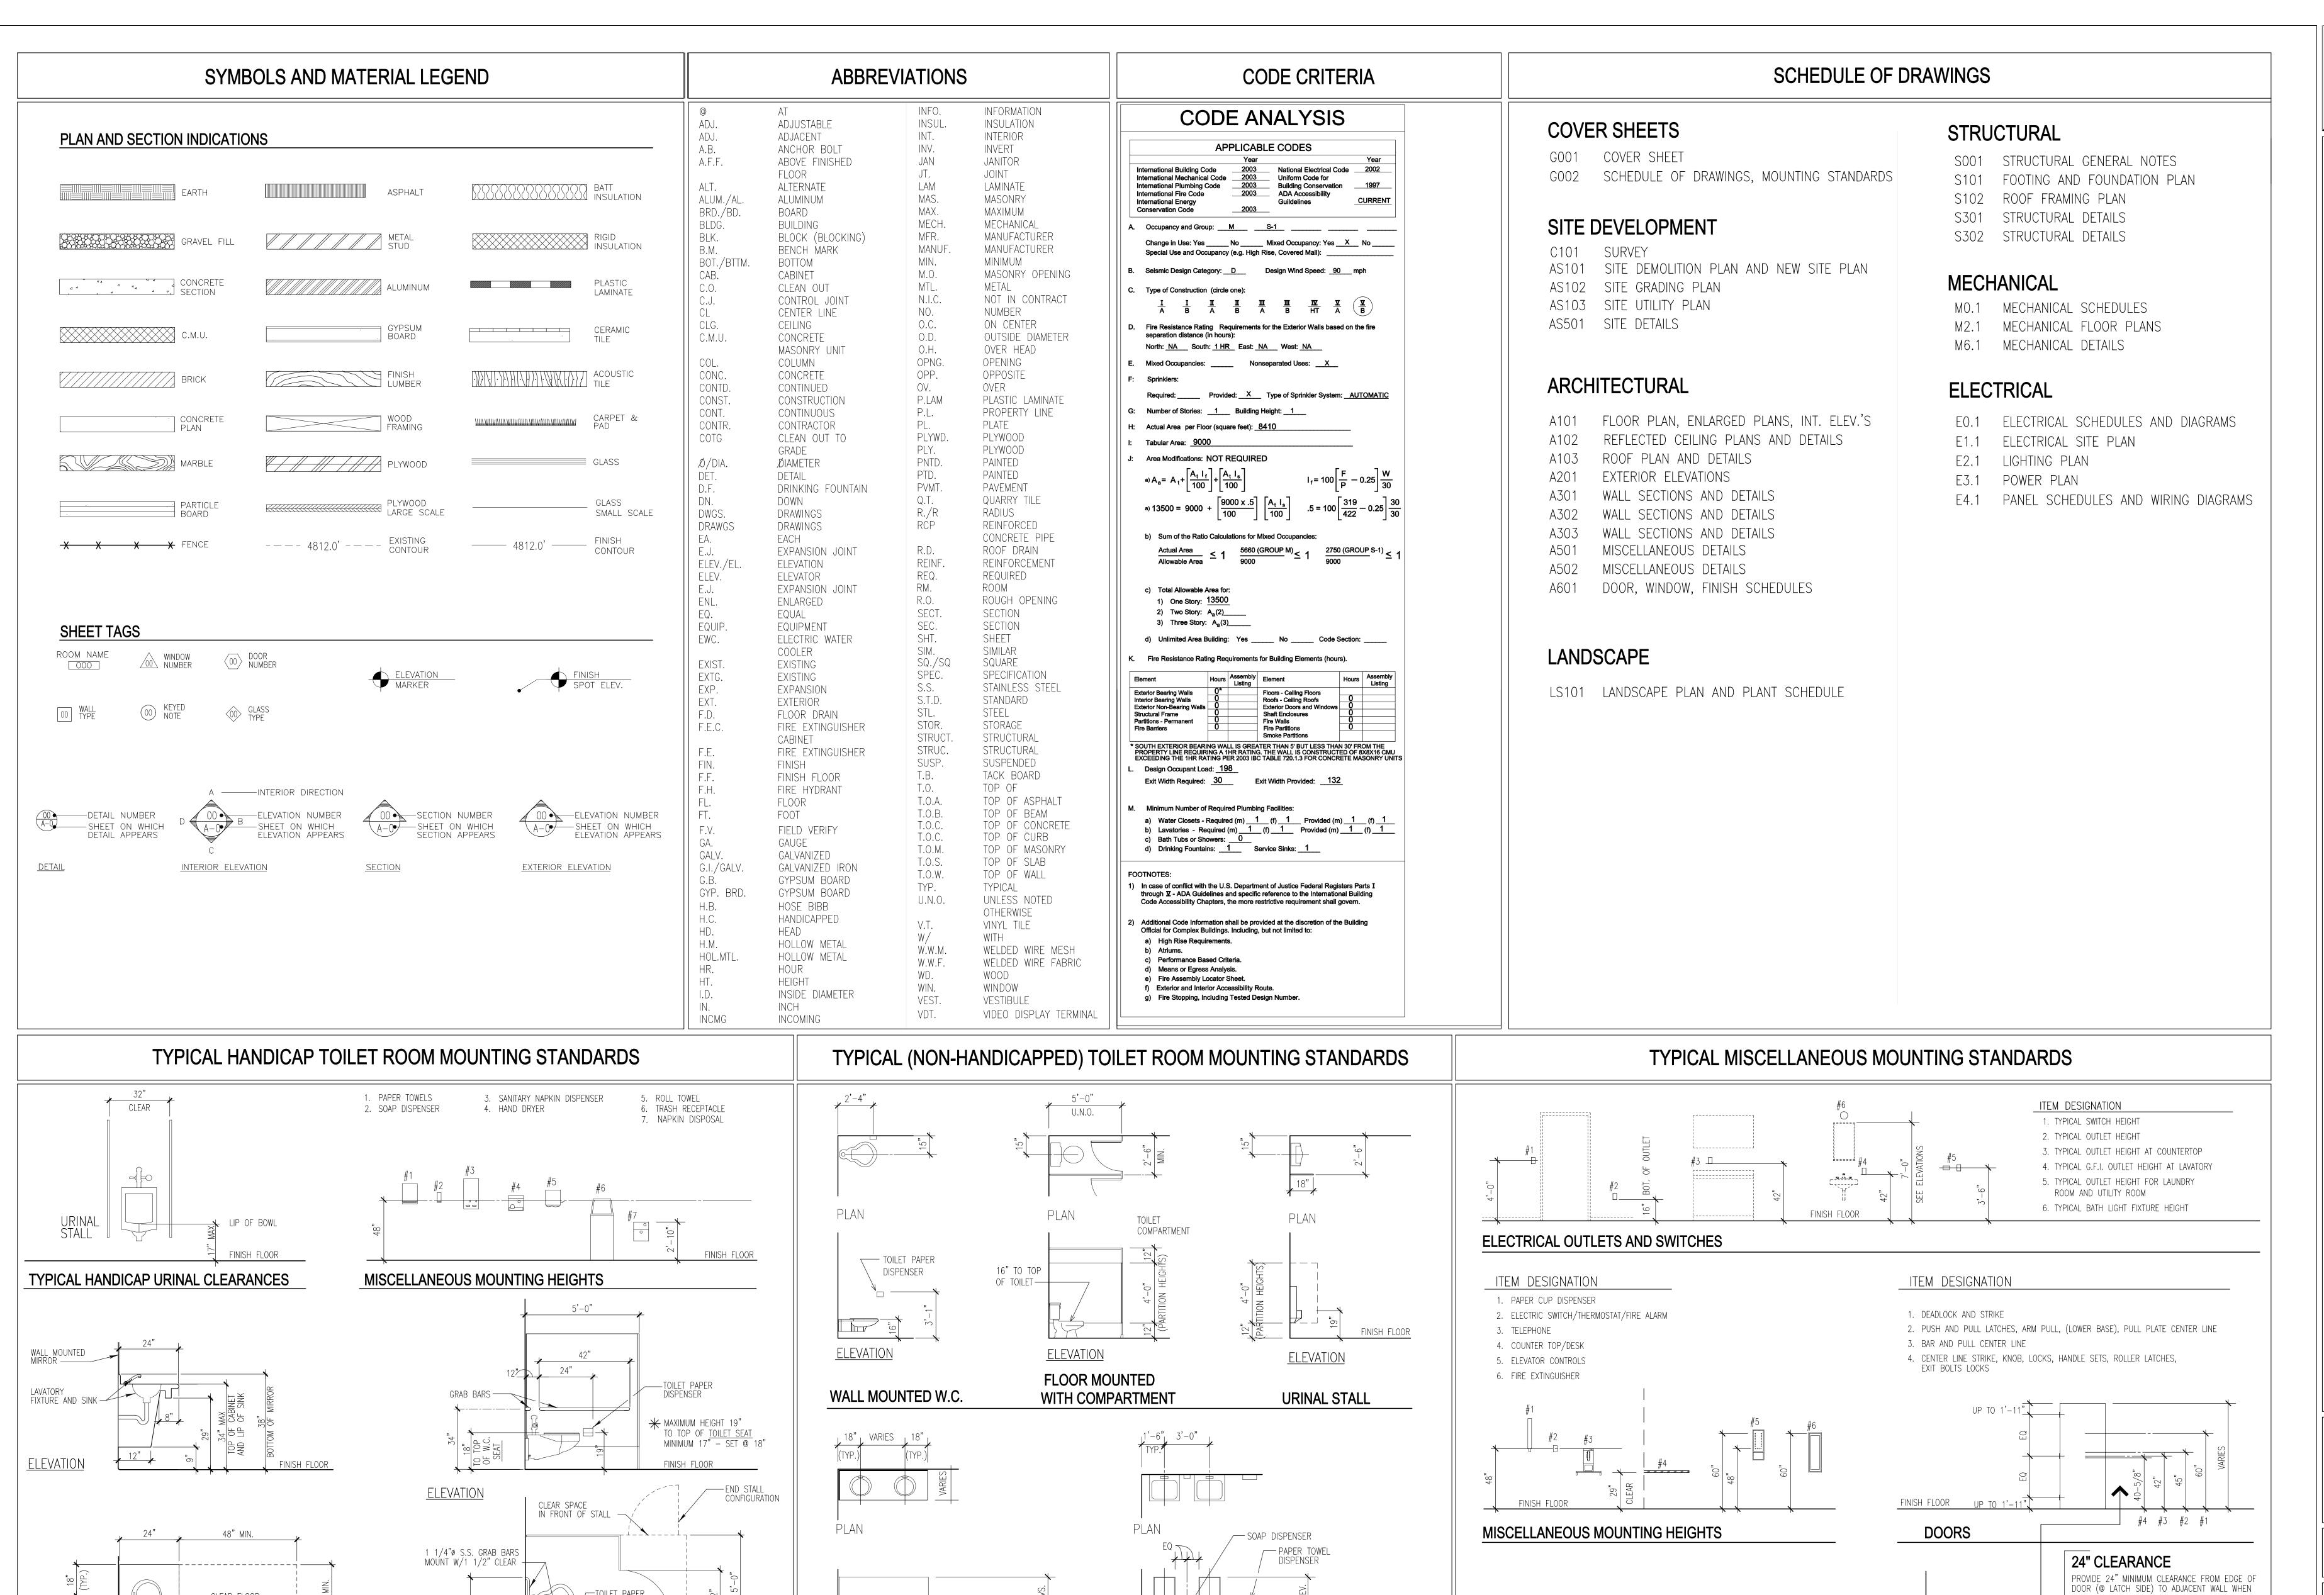

ELEVATION

WALL MTD LAV

FINISH FLOOR

ple, ple

COUNTERTOP LAV

ELEVATION

CLEAR INSIDE

TYPICAL HANDICAP TOILET ROOM CLEARANCES

CLEAR FLOOR

SPACE —

TYPICAL HANDICAP LAVATORY CLEARANCES

REVISION # DATE:

DFCM PROJECT NO. 04242030 CONSTR. DOC.

DOOR <u>PULLS TOWARDS</u> YOU.

18" CLEARANCE

FINISH FLOOR

CLOSETS

8" MIN. 6


ELECTRIC WATER COOLERS

DOOR <u>PUSHES AWAY</u> FROM YOU.

PROVIDE 18" MINIMUM CLEARANCE FROM EDGE OF DOOR (@ LATCH SIDE) TO ADJACENT WALL WHEN

FILE NAME: ABCH-G002 PLOT SCALE: 1:1 DRAWN BY: STAFF CHECKED BY: FNM DATE: JANUARY 24, 2006

002

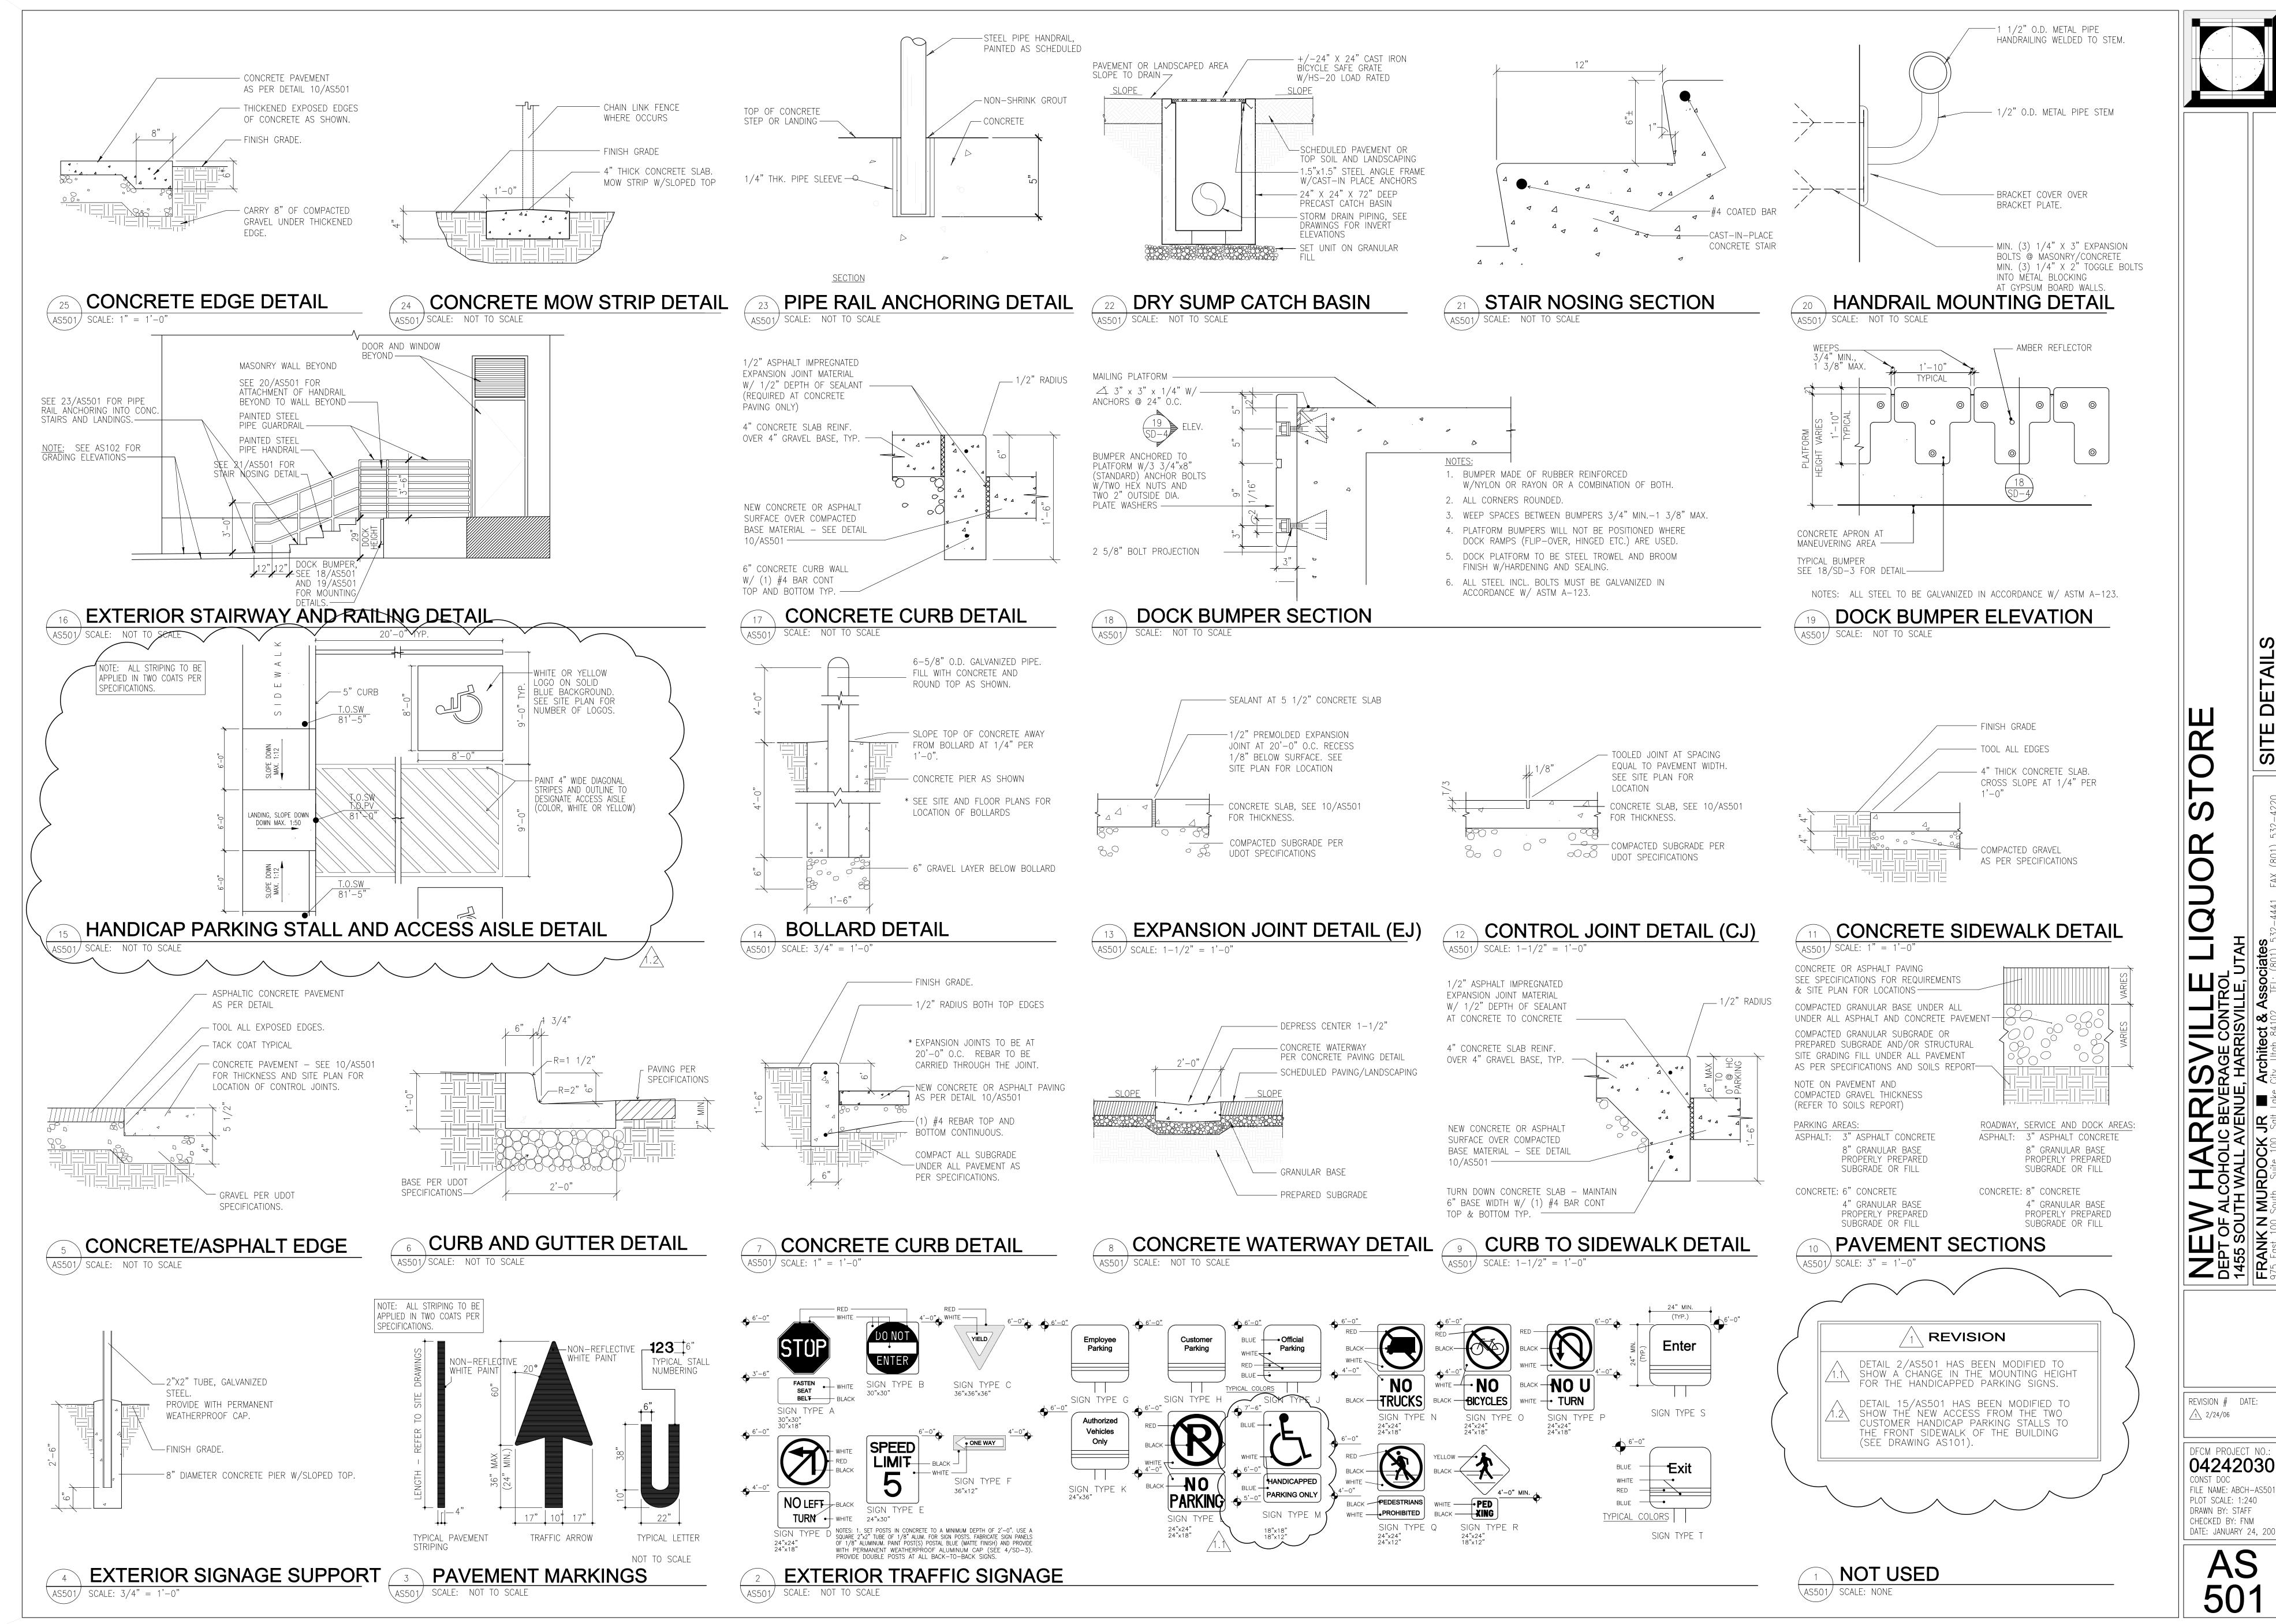



REVISION # DATE:


<u>/1</u> 2/24/06 DFCM PROJECT NO .: 04242030 CONST DOC

DATE: JANUARY 24, 200 AS

501

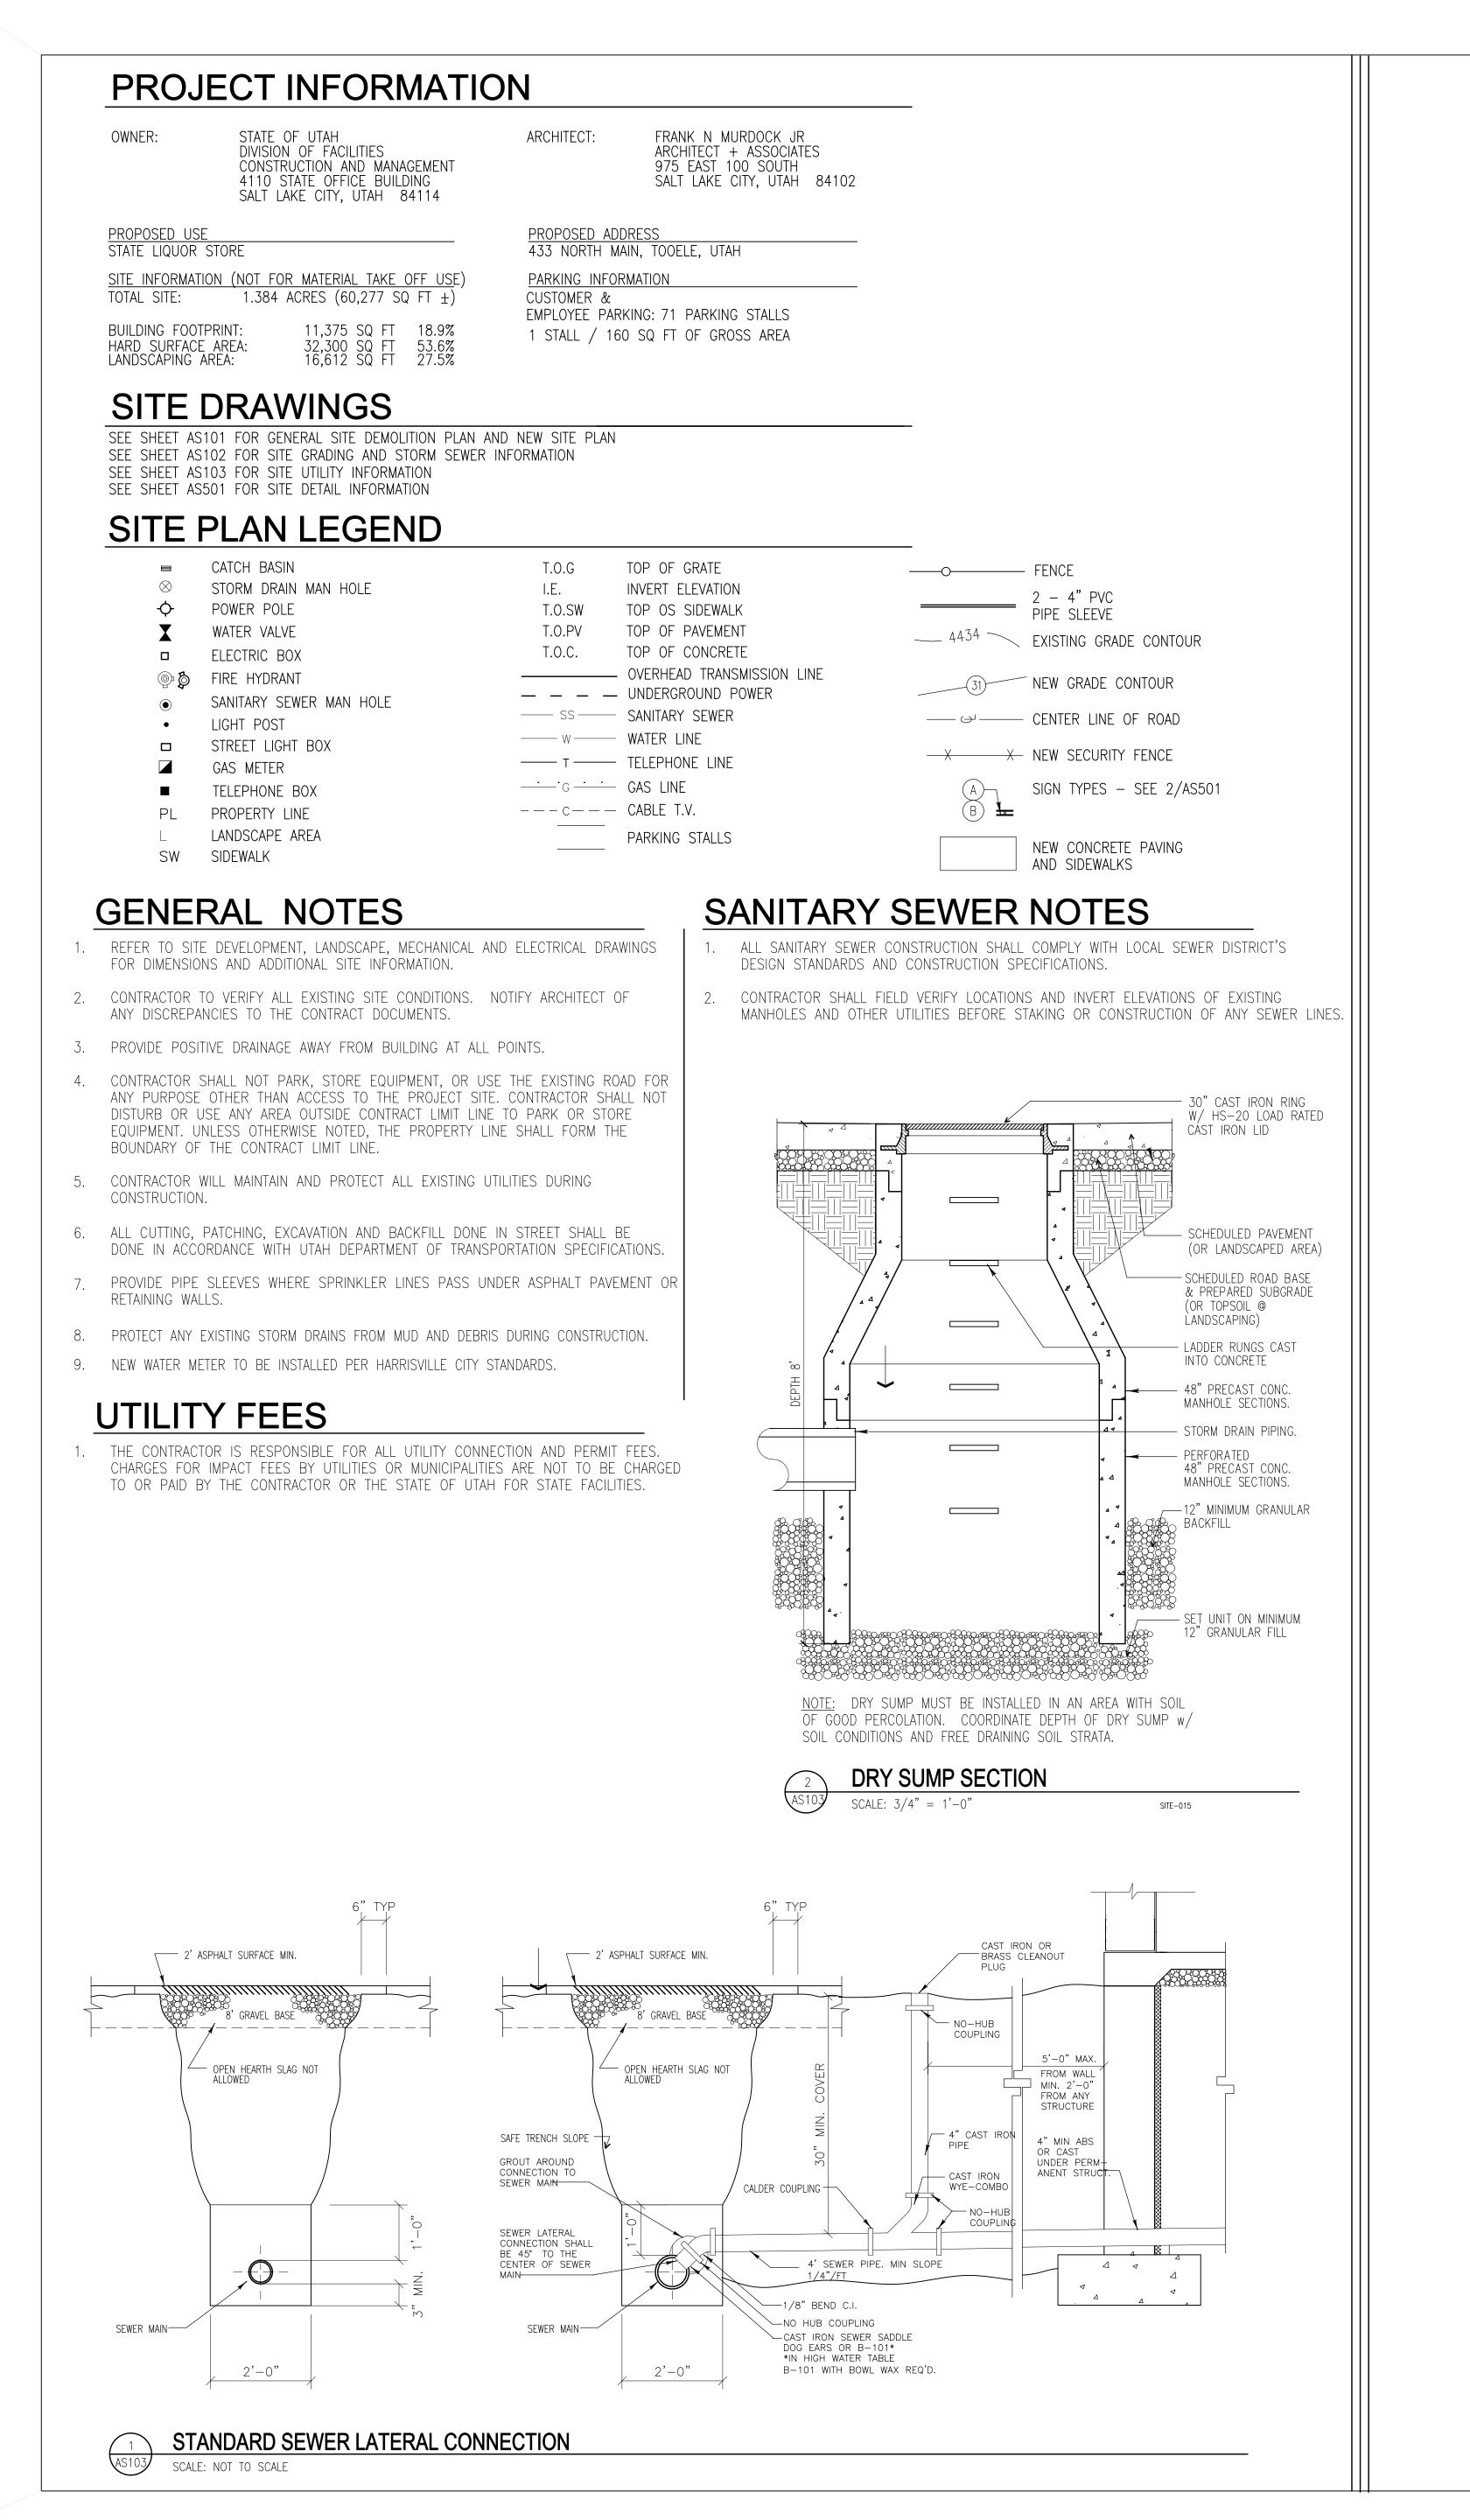

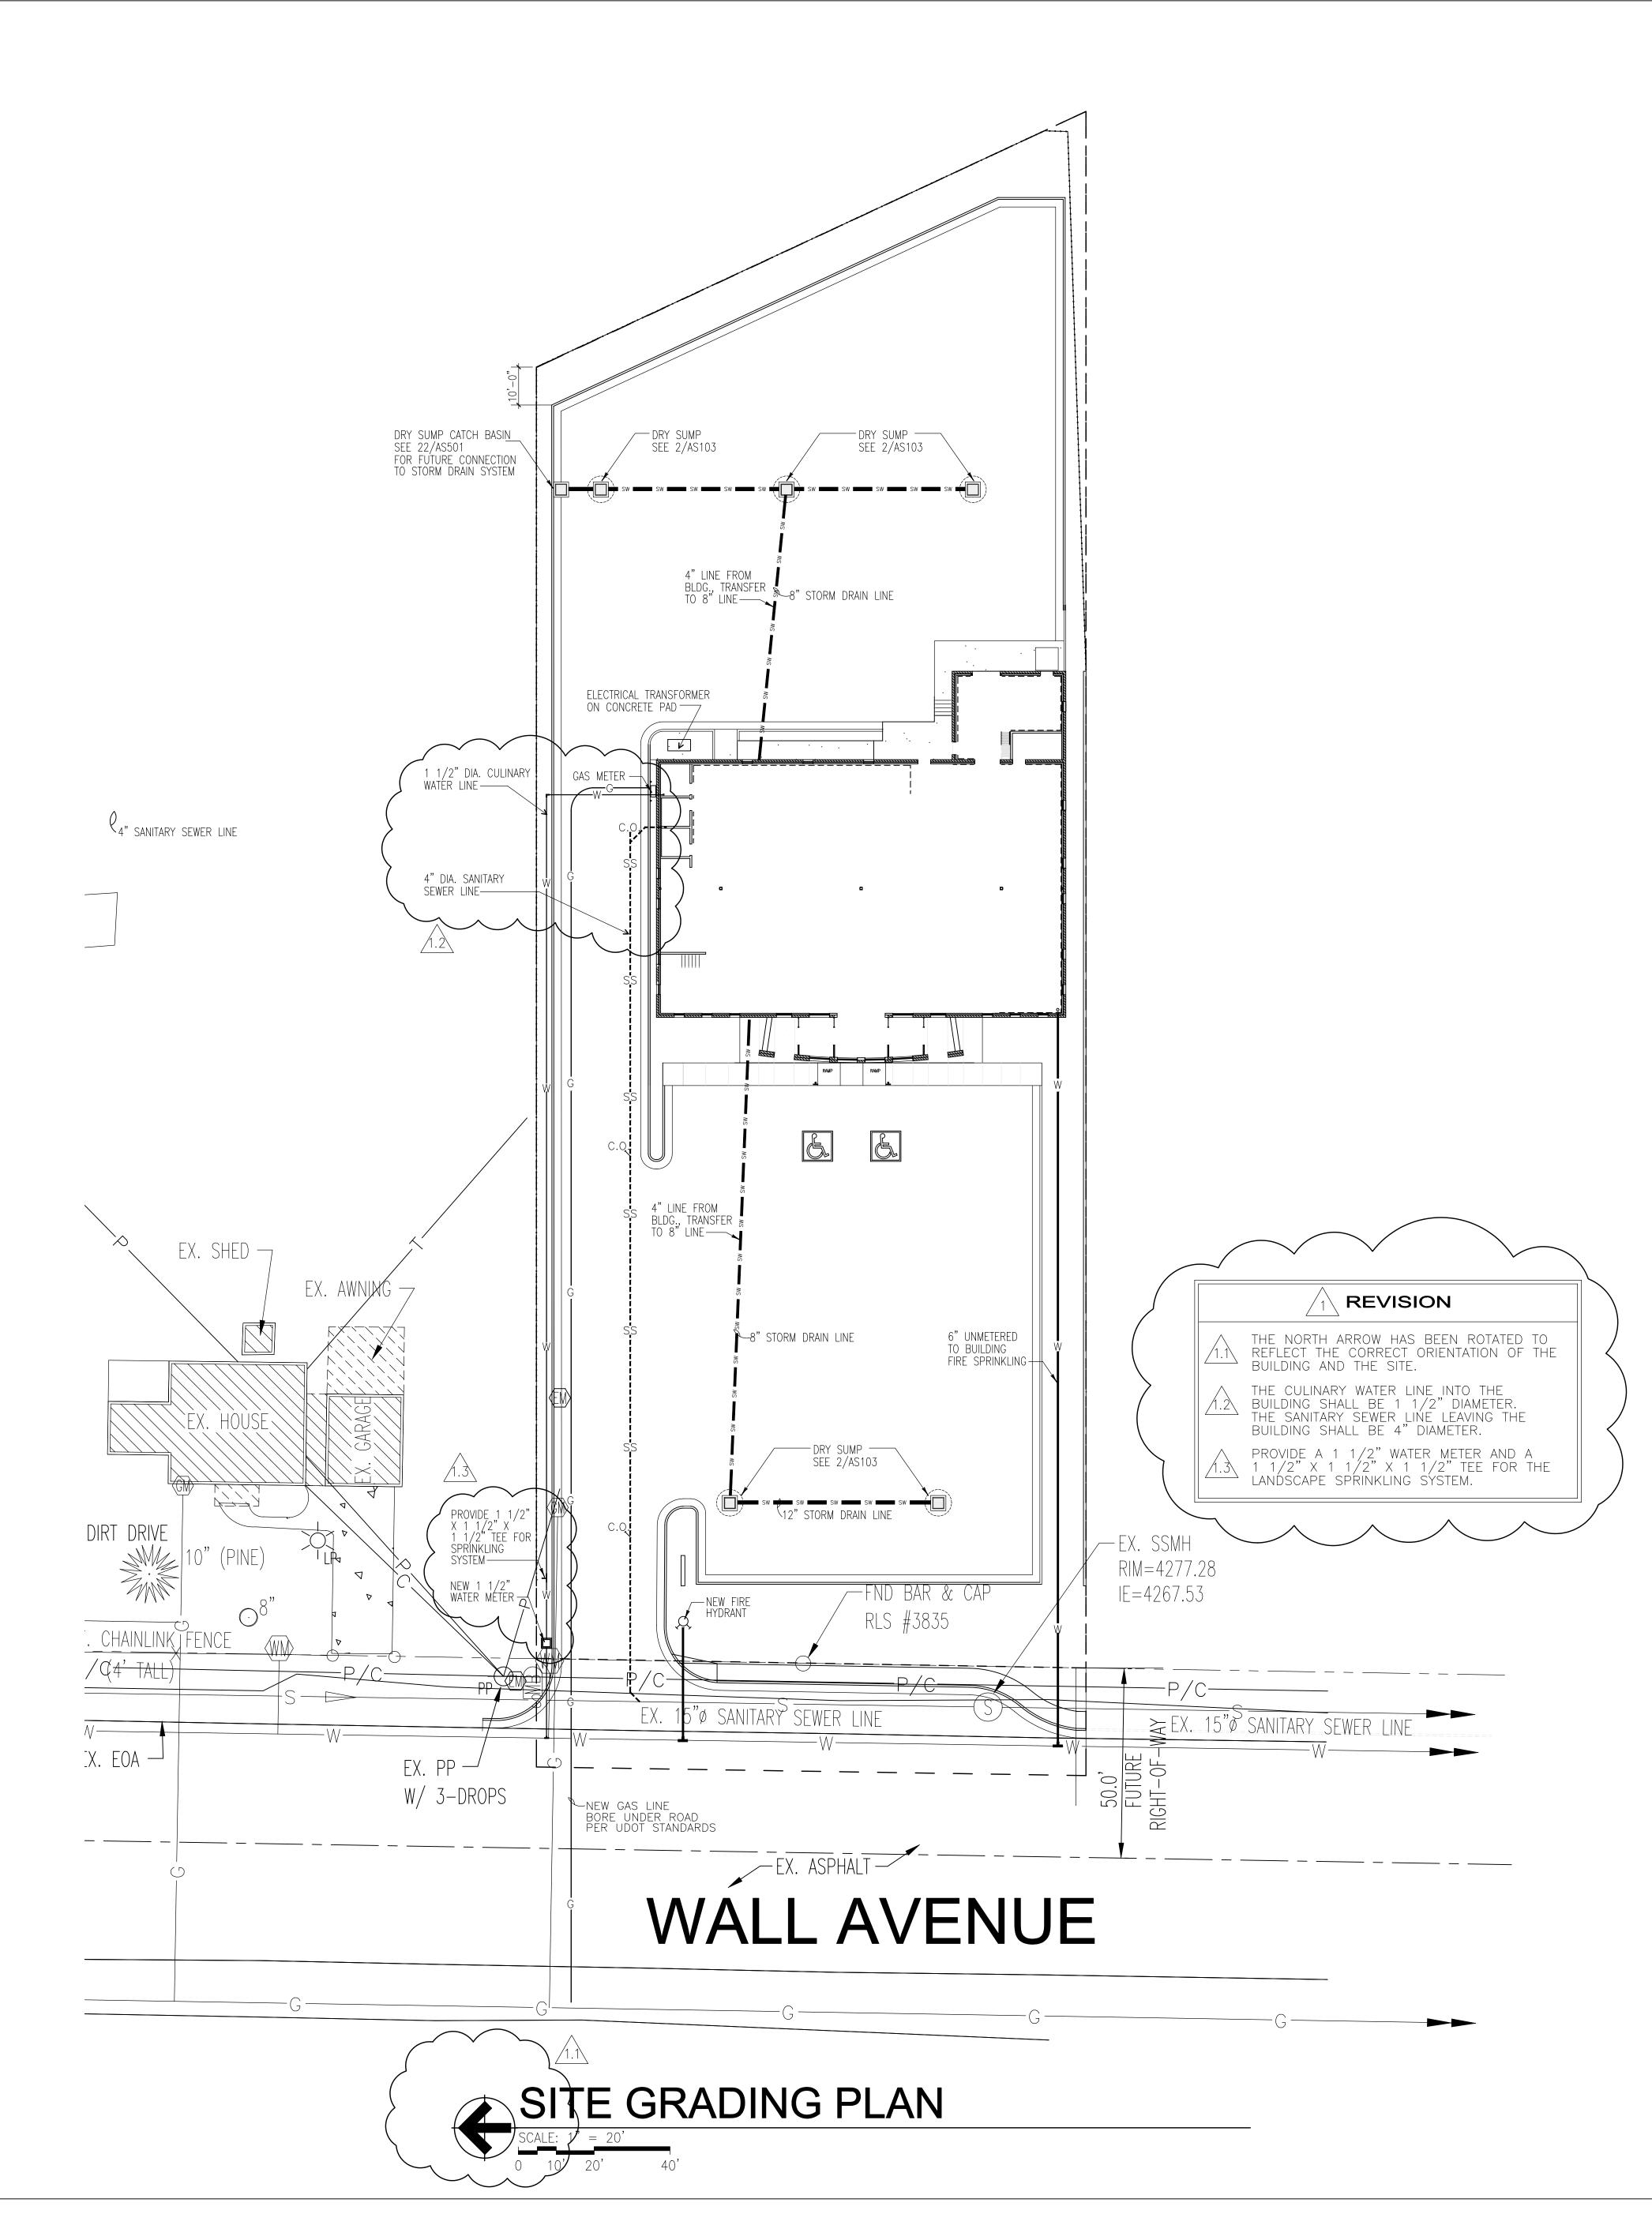

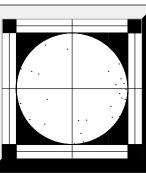

DFCM PROJECT NO. 04242030 FILE NAME: ABCH-AS103 PLOT SCALE: 1:240 DRAWN BY: STAFF CHECKED BY: FNM DATE: JANUARY 24, 200

AS

REVISION # DATE:

<u>/1</u> 2/24/06

Attachment 1

Permit #

Permit Date



COMcheck Software Version 3.2.0

Envelope Compliance Certificate

2003 IECC

Report Date: 03/02/06

Data filename: M:\Projects\2005\05291.00\Files\HARRIS~1.CCK

Section 1: Project Information

Project Title:

Construction Site: Owner/Agent: Designer/Contractor:

Section 2: General Information

Building Location (for weather data): Ogden, Utah

Climate Zone: 12b

Heating Degree Days (base 65 degrees F): 5557
Cooling Degree Days (base 65 degrees F): 1096

Project Type: New Construction

Vertical Glazing / Wall Area Pct.: 0%

Building TypeFloor AreaRetail Sales, Wholesale Showroom7262

Section 3: Requirements Checklist

Envelope TBD: No envelope assemblies specified

Climate-Specific Requirements:

| Component Name/Description Gross Area Cavity Co or R-Value R-V Perimeter |
|--|
|--|

 $[\]hbox{(a) Budget U-factors are used for software baseline calculations $ONLY$, and are not code requirements.}\\$

Air Leakage, Component Certification, and Vapor Retarder Requirements:

- ☐ 1. All joints and penetrations are caulked, gasketed or covered with a moisture vapor-permeable wrapping material installed in accordance with the manufacturer's installation instructions.
- 2. Windows, doors, and skylights certified as meeting leakage requirements.
- ☐ 3. Component R-values & U-factors labeled as certified.
- 4. Insulation installed according to manufacturer's instructions, in substantial contact with the surface being insulated, and in a manner that achieves the rated R-value without compressing the insulation.
- ☐ 5. Stair, elevator shaft vents, and other dampers integral to the building envelope are equipped with motorized dampers.
- ☐ 6. Cargo doors and loading dock doors are weather sealed.
- 7. Recessed lighting fixtures are: (i) Type IC rated and sealed or gasketed; or (ii) installed inside an appropriate air-tight assembly with a 0.5 inch clearance from combustible materials and with 3 inches clearance from insulation material.
- ☐ 8. Building entrance doors have a vestibule and equipped with closing devices. *Exceptions:*

Building entrances with revolving doors.

Doors that open directly from a space less than 3000 sq. ft. in area.

9. Vapor retarder installed.

Project Notes:

Previously saved project information: Harrisville Liquor Store Frank N. Murdock 975 East 100 South Salt Lake City, Utah 84102 Kenneth Gibbs



2003 IECC

Report Date:

Data filename: M:\Projects\2005\05291.00\Files\HARRIS~1.CCK

The following list provides more detailed descriptions of the requirements in Section 4 of the Mechanical Compliance Certificate.

Requirements Specific To: HVAC System 1:

- 1. The specified heating and/or cooling equipment is covered by the ASHRAE 90.1 Code and must meet the following minimum efficiency: Duct Furnace (Gas): 80% Ec
- 2. The specified heating and/or cooling equipment is covered by ASHRAE 90.1 Code and must meet the following minimum efficiency: Rooftop Package Unit: 9.7 SEER

Requirements Specific To: Storage Water Heater 1:

- 1. Piping for the specified circulating service hot water system must be insulated with a minimum of 1-in. insulation having a conductivity no >0.28 Btu-in/(h-ft2-degrees F).
- Circulating service hot water systems must have a time switch control that can automatically turn off the system during unoccupied hours.
- 3. Service water heating equipment used solely for heating potable water, pool heaters, and hot water storage tanks must meet the following miniumum efficiency: Electric Water Heater efficiency >= 0.85 EF, 291 SL, Btu/h (if > 12 kW)

Generic Requirements: Must be met by all systems to which the requirement is applicable:

- 1. Design heating and cooling loads for the building must be determined using procedures in the ASHRAE Handbook of Fundamentals or an approved equivalent calculation procedure.
- 2. All equipment and systems must be sized to be no greater than needed to meet calculated loads. A single piece of equipment providing both heating and cooling must satisfy this provision for one function with the capacity for the other function as small as possible, within available equipment options.
 - Exception: The equipment and/or system capacity may be greater than calculated loads for standby purposes. Standby equipment must be automatically controlled to be off when the primary equipment and/or system is operating.
 - Exception: Multiple units of the same equipment type whose combined capacities exceed the calculated load are allowed if they are provided with controls to sequence operation of the units as the load increases or decreases.
- 3. Each heating or cooling system serving a single zone must have its own temperature control device.
- 4. Each humidification system must have its own humidity control device.
- 5. Thermostats controlling both heating and cooling must be capable of maintaining a 5 degrees F deadband (a range of temperature where no heating or cooling is provided).
 - Exception: Deadband capability is not required if the thermostat does not have automatic changeover capability between heating and cooling.
- 6. The system or zone control must be a programmable thermostat or other automatic control meeting the following criteria:a) capable of setting back temperature to 55 degrees F during heating and setting up to 85 degrees F during coolingb) capable of automatically setting back or shutting down systems during unoccupied hours using 7 different day schedulesc) have an accessible 2-hour occupant overrided) have a battery back-up capable of maintaining programmed settings for at least 10 hours without power.
 - Exception: A setback or shutoff control is not required on thermostats that control systems serving areas that operate continuously.
 - Exception: A setback or shutoff control is not required on systems with total energy demand of 2 kW (6,826 Btu/h) or less.
- 7. Outdoor-air supply systems with design airflow rates >3,000 cfm of outdoor air and all exhaust systems must have dampers that are automatically closed while the equipment is not operating.
- 8. The system must supply outside ventilation air as required by Chapter 4 of the International Mechanical Code. If the ventilation system is designed to supply outdoor-air quantities exceeding minimum required levels, the system must be capable of reducing outdoor-air flow to the minimum required levels.
- 9. Air ducts must be insulated to the following levels:a) Supply and return air ducts for conditioned air located in unconditioned

spaces (spaces neither heated nor cooled) must be insulated with a minimum of R-5. Unconditioned spaces include attics, crawl spaces, unheated basements, and unheated garages.b) Supply and return air ducts and plenums must be insulated to a minimum of R-8 when located outside the building.c) When ducts are located within exterior components (e.g., floors or roofs), minimum R-8 insulation is required only between the duct and the building exterior.

- Exception: Duct insulation is not required on ducts located within equipment.
- Exception: Duct insulation is not required when the design temperature difference between the interior and exterior of the duct or plenum does not exceed 15 degrees F.
- 10. All joints, longitudinal and transverse seams, and connections in ductwork must be securely sealed using weldments; mechanical fasteners with seals, gaskets, or mastics; mesh and mastic sealing systems; or tapes. Tapes and mastics must be listed and labeled in accordance with UL 181A or UL 181B.
 - Exception: Continuously welded and locking-type longitudinal joints and seams on ducts operating at static pressures less than 2 inches w.g. pressure classification.
- 11. Mechanical fasteners and seals, mastics, or gaskets must be used when connecting ducts to fans and other air distribution equipment, including multiple-zone terminal units.
- 12. Operation and maintenance documentation must be provided to the owner that includes at least the following information:a) equipment capacity (input and output) and required maintenance actionsb) equipment operation and maintenance manualsc) HVAC system control maintenance and calibration information, including wiring diagrams, schematics, and control sequence descriptions; desired or field-determined set points must be permanently recorded on control drawings, at control devices, or, for digital control systems, in programming commentsd) complete narrative of how each system is intended to operate.
- 13. Each supply air outlet or diffuser and each zone terminal device (such as VAV or mixing box) must have its own balancing device. Acceptable balancing devices include adjustable dampers located within the ductwork, terminal devices, and supply air diffusers.
- 14. Service water heating equipment must meet minimum Federal efficiency requirements included in the National Appliance Energy Conservation Act and the Energy Policy Act of 1992, which meet or exceed ASHRAE 90.1 Code. New service water heating equipment can be assumed to meet these requirements.
- 15. Water-heating equipment must be provided with controls that allow the user to set the water temperature to 110 degrees F for dwelling units and 90 degrees F for other occupancies. Controls must limit output temperatures of lavatories in public facility restrooms to 110 degrees F.
- 16. Stair and elevator shaft vents must be equipped with motorized dampers capable of being automatically closed during normal building operation and interlocked to open as required by fire and smoke detection systems. All gravity outdoor air supply and exhaust hoods, vents, and ventilators must be equipped with motorized dampers that will automatically shut when the spaces served are not in use. Exceptions: Gravity (non-motorized) dampers are acceptable in buildings less than three stories in height above grade. Ventilation systems serving unconditioned spaces.

Attachment 2

ELECTRICAL ADDEDUM

| Sheet | E0.1 |
|-------|------|
|-------|------|

Item #1 Add additional Lighting Fixture Type "I" Halo H2561 with 60watt A

lamp 120volt.

Item #2 Add additional Lighting Fixture Type "OG" Sure-Lites AEL1-SD-

LASER complete with lamps, 120volt.

Sheet E2.1

Item #1 Lighting fixture at top of the roof hatch is to be a Type "I".

Item #2 Provide install and wire three Type "OG' Lighting fixtures. Locate one at

each outside public door and one between the two man doors at the rear of the building. Wire the additional outdoor emergency fixtures on circuit A-

41.

Sheet E3.1

Item #1 Provide install and wire an additional Fire Alarm Horn Strobe in each

Restroom @ 15 Candelas and loading area a@ 75 Candelas.

Item #2 All of the Fire Alarms System Horn/Strobes are to be 75 Candelas.

Item #3 Power Circuits for the Check-out counter are to be Circuits A-32,32 and

A34,36.

Item #4 Provide install and wire a manual thermal starters to serve a Unit Heater

UH-1 in the Loading area. Circuit to circuit A-24 and make all final connections. Coordinate exact requirements with the mechanical

contractor.

Item #5 Provide install and wire an additional fourplex convenience outlet on the

east wall of the raised Office and circuit to Circuit A-10.

Item #6 The circuit for the ceiling duplex outlet above the Checkout counters is for

the overhead monitor and is to be on circuit A-40.

LIST OF APPROVAL ITEMS

The following items, trade names, products and manufactures are approved for bidding. Approval does not relieve the bidder from satisfying the intent of the requirements of the drawings, specifications, and addenda in every respect. Failure to conform to the design quality and standards specified, established and required may result in later disapproval. If equipment must be disapproved after bidding, supplier shall supply specified equipment at no extra cost to the owner.

Items are listed generally and specific model number, etc. shall be as submitted. Items submitted but not approved either did not satisfy the requirements, or showed insufficient data, or arrived after the 8 day deadline established for the submittal process.

Lighting Fixtures

| A | Daybrite | Lithonia | LSI |
|----|----------|-----------|------------|
| AE | Daybrite | Lithonia | LSI |
| В | Daybrite | Lithonia | LSI |
| BE | Daybrite | Lithonia | LSI |
| C | Daybrite | Lithonia | LSI |
| D | Daybrite | Lithonia | LSI |
| E | Daybrite | Evenlight | Lightguard |
| F | Daybrite | Lithonia | LSI |
| G | Daybrite | Gotham | LSI |
| Н | Daybrite | Contech | LSI |
| X1 | Daybrite | Evenlight | Lightguard |
| OA | Daybrite | Lithonia | Lightguard |
| OB | Daybrite | Lithonia | Lightguard |
| OC | Gardco | Lithonia | LSI |
| OD | Gardco | Lithonia | LSI |
| OE | Gardco | Lithonia | LSI |
| OF | Gardco | Lithonia | LSI |

Attachment 3



COMcheck Software Version 3.2.0

Lighting Application Worksheet

2003 IECC

Report Date:

Data filename: M:\Projects\2005\05291.00\Files\HARRIS~1.CCK

Section 1: Allowed Lighting Power Calculation

| А | B Floor Area | C Allowed Watts / ft2 | D Allowed Watts |
|----------------------------------|-----------------|-----------------------------|--------------------|
| Retail Sales, Wholesale Showroom | 7262 | 1.5 | 10893 |
| | Tota | al Allowed Watts = | 10893 |

Section 2: Actual Lighting Power Calculation

| A Fixture ID: Description / Lamp / Wattage Per Lamp / Ballast | B Lamps/ Fixture | C # of Fixtures | D Fixture Watt. | (C X D) |
|---|------------------------|-----------------------|-----------------------|---------|
| T8 / T12 Fluorescent 1: A.B: 2 x 4 Troffer / 48" T8 32W / Electronic | 3 | 70 | 96 | 6720 |
| T8 / T12 Fluorescent 2: F: 4 Lamp Industrial / 48" T8 32W / Electronic | 4 | 5 | 110 | 550 |
| T8 / T12 Fluorescent 3: C: 2 Lamp wall fluores. / 48" T8 32W / Electronic | 2 | 2 | 68 | 136 |
| Compact Fluorescent 1: G: Rec Fluorescent / Triple 4-pin 42W / Electronic | 1 | 8 | 48 | 384 |
| | | Total Actua | al Watts = | 7790 |

Section 3: Compliance Calculation

If the Total Allowed Watts minus the Total Actual Watts is greater than or equal to zero, the building complies.

Total Allowed Watts = 10893 Total Actual Watts = 7790 Project Compliance = 3103

Lighting PASSES: Design 28% better than code.

Permit #

Permit Date



COMcheck Software Version 3.2.0

Mechanical Compliance Certificate

2003 IECC

Report Date: 03/02/06

Data filename: M:\Projects\2005\05291.00\Files\HARRIS~1.CCK

Section 1: Project Information

Project Title:

Construction Site: Owner/Agent: Designer/Contractor:

Section 2: General Information

Building Location (for weather data): Ogden, Utah

Climate Zone: 12b
Heating Degree Days (base 65 degrees F): 5557
Cooling Degree Days (base 65 degrees F): 1096

Project Type: New Construction

Section 3: Mechanical Systems List

Quantity System Type & Description

- 4 HVAC System 1: Heating: Duct Furnace, Gas / Cooling: Rooftop Package Unit, Capacity <65 kBtu/h, Air-Cooled Condenser / Single Zone</p>
- 1 Storage Water Heater 1: Service Water Heater w/ Circulation Pump

Section 4: Requirements Checklist

Requirements Specific To: HVAC System 1:

- 1. Equipment minimum efficiency: Duct Furnace (Gas): 80% Ec
- ☐ 2. Equipment minimum efficiency: Rooftop Package Unit: 9.7 SEER

Requirements Specific To: Storage Water Heater 1:

- ☐ 1. 1-in. pipe insulation on circulation systems
- 2. Automatic on/off control required for circulating systems
- ☐ 3. Electric Water Heater efficiency >= 0.85 EF, 291 SL, Btu/h (if > 12 kW)

Generic Requirements: Must be met by all systems to which the requirement is applicable:

- 1. Load calculations per 2001 ASHRAE Fundamentals
- 2. Plant equipment and system capacity no greater than needed to meet loads
 - Exception: Standby equipment automatically off when primary system is operating
- Exception: Multiple units controlled to sequence operation as a function of load
- ☐ 3. Minimum one temperature control device per system
- 4. Minimum one humidity control device per installed humidification/dehumidification system
- ☐ 5. Thermostatic controls has 5 degrees F deadband
 - Exception: Thermostats requiring manual changeover between heating and cooling
- ☐ 6. Automatic Controls: Setback to 55 degrees F (heat) and 85 degrees F (cool); 7-day clock, 2-hour occupant override, 10-hour backup
 - Exception: Continuously operating zones

Attachment 4

Permit #

Permit Date



2003 IECC

Report Date: 03/02/06

Data filename: M:\Projects\2005\05291.00\Files\HARRIS~1.CCK

| Section 1: Project Information | ection 1: Projec | ct information | on |
|--------------------------------|------------------|----------------|----|
|--------------------------------|------------------|----------------|----|

| _ | | | |
|-----|-------|-----|--------------|
| Pro | + | T:+ | |
| -10 | IEC:I | | \leftarrow |
| | | | |

Construction Site: Owner/Agent: Designer/Contractor:

Section 2: General Information

Building Use Description by:

Project Type: New Construction

Building TypeFloor AreaRetail Sales, Wholesale Showroom7262

Section 3: Requirements Checklist

Interior Lighting:

| 」 | 1. | Tota | l actual | watts | must | be | less | than | or | equal | to | tota | al | lowed | watts | ŝ. |
|----------|----|------|----------|-------|------|----|------|------|----|-------|----|------|----|-------|-------|----|
|----------|----|------|----------|-------|------|----|------|------|----|-------|----|------|----|-------|-------|----|

Allowed Watts Actual Watts Complies
10893 7790 YES

■ 2. Exit signs 5 Watts or less per side.

Exterior Lighting:

☐ 3. Efficacy greater than 45 lumens/W.

Exceptions:

Specialized lighting highlighting features of historic buildings; signage; safety or security lighting; low-voltage landscape lighting.

Controls, Switching, and Wiring:

Independent controls for each space (switch/occupancy sensor).

Exceptions:

Areas designated as security or emergency areas that must be continuously illuminated.

Lighting in stairways or corridors that are elements of the means of egress.

- 5. Master switch at entry to hotel/motel guest room.
- ☐ 6. Individual dwelling units separately metered.
- 7. Each space provided with a manual control to provide uniform light reduction by at least 50%.
 Exceptions:

Only one luminaire in space;

An occupant-sensing device controls the area;

The area is a corridor, storeroom, restroom, public lobby or guest room;

Areas that use less than 0.6 Watts/sq.ft.

- 8. Automatic lighting shutoff control in buildings larger than 5,000 sq.ft.
- 9. Photocell/astronomical time switch on exterior lights.

| | Exceptions: Lighting intended for 24 hour use | | | | |
|---------------------------------|---|--|--------------------|--|--|
| 1 0. | Exceptions: | amp ballasted luminaires (No single-lamp ballasts). s; Luminaires on emergency circuits or with no available pair. | | | |
| Section 4: Compliance Statement | | | | | |
| specific meet th | cations and other calculations submitt | ng design represented in this document is consistent with the builed with this permit application. The proposed lighting system has ts in COM check Version 3.2.0 and to comply with the mandatory | s been designed to | | |
| Princip | al Lighting Designer-Name | Signature | Date | | |

| nequii | enients onechist. | | |
|-------------------|---|---|--|
| specifi to med | cations and other calculations submitt | nanical design represented in this document is ted with this permit application. The proposed Mcheck Version 3.2.0 and to comply with the | I mechanical systems have been designed |
| Sec | etion 5: Compliance | Statement | |
| ☐ 14 ☐ 15 | Newly purchased service water hear | ting equipment meets the efficiency requirem 110 degrees F for dwelling units or 90 degree | |
| <u> </u> | Operation and maintenance manual Balancing devices provided in accor | provided to building owner | ршен |
| □ 11 | pressures less than 2 inches | lded and locking-type longitudinal joints and s s w.g. pressure classification used to connect ducts and air distribution equ | |
| 1 0 | Ducts sealed - longitudinal seams of | or and exterior temperature difference not exc n rigid ducts; transverse seams on all ducts; | UL 181A or 181B tapes and mastics |
| 9. | R-5 supply and return air duct insula building R-8 insulation between duc | ation in unconditioned spaces R-8 supply and its and the building exterior when ducts are pa | return air duct insulation outside the |
| ☐ 7. ☐ 8. | Automatic shut-off dampers on exha | stem capable of reducing OSA to required m | The state of the s |
| | Exception: 2 kW demand or | less, submit calculations | |

Attachment 6

ELECTRICAL ADDEDUM

| Sheet | E0.1 |
|-------|------|
|-------|------|

Item #1 Add additional Lighting Fixture Type "I" Halo H2561 with 60watt A

lamp 120volt.

Item #2 Add additional Lighting Fixture Type "OG" Sure-Lites AEL1-SD-

LASER complete with lamps, 120volt.

Sheet E2.1

Item #1 Lighting fixture at top of the roof hatch is to be a Type "I".

Item #2 Provide install and wire three Type "OG' Lighting fixtures. Locate one at

each outside public door and one between the two man doors at the rear of the building. Wire the additional outdoor emergency fixtures on circuit A-

41.

Sheet E3.1

Item #1 Provide install and wire an additional Fire Alarm Horn Strobe in each

Restroom @ 15 Candelas and loading area a@ 75 Candelas.

Item #2 All of the Fire Alarms System Horn/Strobes are to be 75 Candelas.

Item #3 Power Circuits for the Check-out counter are to be Circuits A-32,32 and

A34,36.

Item #4 Provide install and wire a manual thermal starters to serve a Unit Heater

UH-1 in the Loading area. Circuit to circuit A-24 and make all final connections. Coordinate exact requirements with the mechanical

contractor.

Item #5 Provide install and wire an additional fourplex convenience outlet on the

east wall of the raised Office and circuit to Circuit A-10.

Item #6 The circuit for the ceiling duplex outlet above the Checkout counters is for

the overhead monitor and is to be on circuit A-40.

LIST OF APPROVAL ITEMS

The following items, trade names, products and manufactures are approved for bidding. Approval does not relieve the bidder from satisfying the intent of the requirements of the drawings, specifications, and addenda in every respect. Failure to conform to the design quality and standards specified, established and required may result in later disapproval. If equipment must be disapproved after bidding, supplier shall supply specified equipment at no extra cost to the owner.

Items are listed generally and specific model number, etc. shall be as submitted. Items submitted but not approved either did not satisfy the requirements, or showed insufficient data, or arrived after the 8 day deadline established for the submittal process.

Lighting Fixtures

| A | Daybrite | Lithonia | LSI |
|------------|----------|-----------|------------|
| AE | Daybrite | Lithonia | LSI |
| В | Daybrite | Lithonia | LSI |
| BE | Daybrite | Lithonia | LSI |
| C | Daybrite | Lithonia | LSI |
| D | Daybrite | Lithonia | LSI |
| E | Daybrite | Evenlight | Lightguard |
| F | Daybrite | Lithonia | LSI |
| G | Daybrite | Gotham | LSI |
| Н | Daybrite | Contech | LSI |
| X 1 | Daybrite | Evenlight | Lightguard |
| OA | Daybrite | Lithonia | Lightguard |
| OB | Daybrite | Lithonia | Lightguard |
| OC | Gardco | Lithonia | LSI |
| OD | Gardco | Lithonia | LSI |
| OE | Gardco | Lithonia | LSI |
| OF | Gardco | Lithonia | LSI |

Attachment 7

STRUCTURAL ADDENDUM

Harrisville Liquor Store

February 22, 2006


The following items must be included into the structural requirements for this project:

- 1) Reinforcing steel in concrete and masonry construction shall be spliced as indicated in the respective schedules on attached sheets SA1.0, and SA1.1.
- 2) The masonry piers between openings in the masonry walls on grid 4 shall have bond beam spacing adjusted to comply with the schedule on attached sheet SA1.2. This only applies to walls on grid 4.
- 3) Footing type FC6.5 shall be reinforced as indicated in the revised schedule on attached sheet SA1.3.
- 4) On sheet S101, Footing and Foundation Plan revise the column size at E3, D3, and C3 from HSS4X4X1/4 to HSS5X5X1/4.

| | | MASON | RY REB | AR SPLI | CE SCH | EDULE | | | |
|----------------|-------|-------|--------|---------|--------|--------|--------|------|------|
| BAR SIZE | #3 | #4 | #5 | #6 | #7 | #8 | #9 | #10 | #11 |
| MAS SINGLE MAT | 1'-7" | 2'-1" | 2'-7" | 4'-4" | 5'-1" | 6'-2" | 7'-10" | MECH | MECH |
| MAS DOUBLE MAT | 1'-7" | 2'-4" | 3'-6" | 6'-10" | 9'-1" | 12'-5" | 15'-4" | MECH | MECH |
| | | | | | | | | | |


MASONRY REBAR SPLICE NOTES:

- 1. MECH = MECHANICAL SPLICE REQUIRED.
- 2. USE #6 BAR IN 10" OR LARGER WALLS ONLY.
- 3. f'm = 1500 PSI, fy = 60,000 PSI
- 4. DOUBLE MAT REINFORCEMENT SHALL HAVE 2" CLEARANCE BETWEEN FACE OF WALL AND EDGE OF

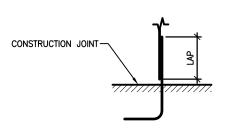


REBAR DEVELOPMENT DETAIL


| | MASONRY STANDARD HOOKS | | | | | | | | | |
|------------|------------------------|----------|-------|------|----------|--|--|--|--|--|
| BAR SIZE | STAN | MIN BEND | | | | | | | | |
| (D) | 90° | 180° | 90° | 135° | DIAMETER | | | | | |
| #3 | 4½" | 2½" | 21/4" | 2" | 2½" | | | | | |
| #4 | 6" | 2½" | 3" | 3" | 2½" | | | | | |
| # 5 | 7½" | 2½" | 3¾" | 3¾" | 2½" | | | | | |
| #6 | 9" | 3" | 4½" | 4½" | 3" | | | | | |
| #7 | 10½" | 3½" | 5¼" | 5¼" | 3½" | | | | | |
| #8 | 12" | 4" | 6" | 6" | 4" | | | | | |
| | | | | | | | | | | |

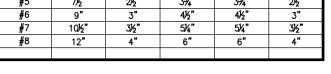

- MASONRY STANDARD HOOK NOTES:


 1. STANDARD HOOKS SHALL BE AROUND A PERPENDICULAR BAR, UNLESS NOTED OTHERWISE ON DRAWINGS.
- 2. ALTERNATIVE HOOKS ARE ONLY ALLOWED FOR MASONRY COLUMN TIES AND
- 3. COLUMN TIES SHALL BE 180° STANDARD OR 135° ALTERNATE HOOK. BEND DIAMETER IS MEASURED FROM INSIDE FACE OF REINFORCING.

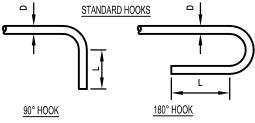

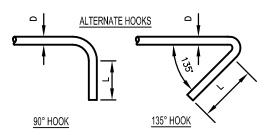



| PROJECT: HARRIS' | VILLE LIQUOR STORE |
|------------------|--------------------|
| JOB No: 06031 | SCALE: AS NOTED |
| DRAWN BY: SD | DESIGNED BY: KC |
| DATE: 2-22-2006 | SA1.0 |

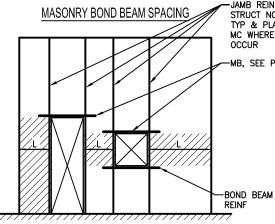

-JAMB REINF SEE STRUCT NOTES FOR TYP & PLANS FOR MC WHERE THEY

-MB, SEE PLAN

| L | MAX BOND BEAM SPACING |
|------------------|-----------------------|
| 0'-8" TO 3'-4" | 8" |
| 4'-0" TO 5'-4" | 16" |
| 6'-0" TO 7'-4" | 24" |
| 8'-0" TO 9'-4" | 32" |
| 10'-0" TO 11'-4" | 40" |
| 12'-0" OR LARGER | 48" |
| • | |

MASONRY BOND BEAM NOTES:

1. BOND BEAM SPACING SHALL NOT EXCEED DISTANCE INDICATED BY TABLE INSIDE HATCHED AREAS. (EX: IF L=4'-8", BOND BEAMS SHALL NOT EXCEED 16" O.C.).

2. REGIONS OUTSIDE THE HATCHED ZONES MAY BE REINFORCED WITH REINFORCING INDICATED ON PLANS.

- 3. WHERE BOND BEAM REINFORCING SPACING IS ½ OR LESS THAN THAT REQD BY THE WALL SCHEDULE. BOND BEAM REINFORCING MAY BE REDUCED BY ½.
- 4. ALL HORIZONTAL REINFORCING SHALL TERMINATE WITH A STANDARD HOOK AROUND VERTICAL REINFORCING.



| PROJECT: | HARRIS' | VILLE LIQUOR STORE |
|---------------|---------|--------------------|
| JOB No: 06031 | | SCALE: AS NOTED |
| DRAWN BY: SD | | DESIGNED BY: KC |
| DATE: 2-2 | 22-2006 | SA1.2 |

| | REINFORCING LAP LENGTH SPLICE SCHEDULES | | | | | | | | | | | | | | | |
|------|---|---------|-------|------|------|-------------|--------|------|------|---------|-------|------|------|---------|--------|-----|
| | TENSION BARS "Ld" | | | | | | | | | | | | | | | |
| | | f'c= 30 | 00psi | | | f'c= 40 | 000psi | | | f'c= 50 | 00psi | | | f'c= 60 | 000psi | |
| BAR | REGULAR TOP | | OP | REGU | JLAR | TO | Р | REG | ULAR | T | OP | REG | ULAR | TC |)P | |
| SIZE | CLA | .SS | CLA | SS | CLA | SS | CLA | SS | CLA | ASS | CLA | ASS | CLA | SS | CL/ | ASS |
| | Α | В | Α | В | Α | В | Α | В | Α | В | Α | В | Α | В | Α | В |
| #3 | 17" | 22" | 22" | 28" | 15" | 19" | 19" | 24" | 13" | 17" | 17" | 22" | 12" | 16" | 16" | 21" |
| #4 | 22" | 29" | 29" | 38" | 18" | 25" | 26" | 33" | 17" | 22" | 23" | 30" | 16" | 20" | 21" | 27" |
| #5 | 28" | 36" | 37" | 48" | 24" | 31" | 32" | 42" | 21" | 28" | 24" | 37" | 20" | 25" | 26" | 34" |
| #6 | 33" | 43" | 45" | 58" | 29" | 37" | 39" | 50" | 26" | 33" | 35" | 45" | 24" | 30" | 32" | 41" |
| #7 | 48" | 63" | 63" | 82" | 42" | 55" | 55" | 71" | 37" | 48" | 48" | 62" | 34" | 45" | 45" | 58" |
| #8 | 55" | 72" | 72" | 93" | 48" | 63" | 63" | 81" | 42" | 55" | 55" | 71" | 39" | 51" | 51" | 66" |
| #9 | 62" | 81" | 81" | 105" | 54" | 71" | 71" | 92" | 48" | 62" | 62" | 80" | 44" | 57" | 57" | 74" |
| #10 | 70" | 91" | 91" | 118" | 61" | 79 " | 79" | 103" | 54" | 70" | 70" | 90" | 50" | 65" | 65" | 84" |
| #11 | 78" | 101" | 101" | 131" | 68" | 88" | 88" | 114" | 60" | 77" | 77" | 100" | 55" | 72" | 72" | 93" |

NOTES:

- 1. THE SCHEDULE SHOWN APPLIES TO REG. WT. CONCRETE WITH 60ksi GRADE REINFORCING BARS.
- 2. TOP BARS ARE HORIZONTAL BARS WITH 12" (OR MORE), OF FRESH CONCRETE CAST BELOW THE BARS.
- 3. CLASS "A" SPLICES SHALL BE USED WHEN 50% (OR LESS) OF BARS SPLICED WITHIN LAP.
- 4. CLASS "B" SPLICES SHALL BE USED FOR ALL ELSE, TYPICALLY W/ SHEARWALLS, COLUMNS, BEAMS & SLABS.
- 5. FOR EPOXY COATED BARS, INCREASE LAP LENGTHS AS FOLLOWS:

TOP BARS - Ld x 1.7

REGULAR BARS - Ld x 1.5

6. FOR BUNDLED BARS, INCREASE LAP LENGTHS AS FOLLOWS:

BUNDLED BARS THREE OR LESS - Ld \times 1.2

BUNDLED BARS FOUR OR MORE - Ld x 1.33

INDIVIDUAL BAR SPLICES WITHIN A BUNDLE SHALL NOT OVERLAP.

7. LAP SPLICES ARE NOT ALLOWED FOR TIES AND STIRRUPS.



| PROJECT: HARRIS | SVILLE LIQUOR STORE |
|-----------------|---------------------|
| JOB No: 06031 | SCALE: AS NOTED |
| DRAWN BY: SD | DESIGNED BY: KC |
| DATE: 2-22-2006 | SA1.1 |

| | FOOTING SCHEDULE | | | | | | | | | | | | |
|--------------|------------------|--------------|--------|--------|--------------------|-----------------|--------------------|-------------|------------|------------|--------------------|---------|------------------|
| | MARK | WIDTH | LENGTH | THICK | NO. | ROSS SIZE | wise rei Length | NF. SPA. | NO. | | IWISE RE LENGTH | | NOTES |
| | FC2.0 | 2'-0" | CONT. | 12" | - | | | | (2) | # 5 | CONT. | EQ. | |
| | FC2.0* | 2'-0" | CONT. | 12" | | | | | (2) | # 5 | CONT. | EQ. | * THICKENED SLAB |
| | FC3.0 | 3'-0" | CONT. | 12" | | #4 | 2'-6" | 18" | (3) | # 5 | CONT. | EQ. | |
| | FC4.0 | 4'-0" | CONT. | | SEE DETAIL 13/S301 | | | | | | | | |
| \downarrow | FC5.5 | 5'-6" | CONT | \ \ | ~~ | ~~ | ~~~ | ŞEĘ | DET/ | AL_13 | /S301_ | ~~~ | ~~~~~ |
| | FC6.5 | 6'-6" | 6'-6" | 12" | (7) | # 5 | 6'-0" | EQ. | (7) | # 5 | 6'-0" | EQ. | |
| F | F\$4.0 | 4 −0° | 4'-0" | 12" | (4) | ^# 4 | ~ 3 '−6"^ | ĚQ. | (4) | #4 | 3 '−6"^ |) EG | |
| | FS7.5 | 7'-6" | 7'-6" | 12" | (8) | # 5 | 7'-0" | EQ. | (8) | #5 | 7'-0" | EQ. | |
| | | | | | | | | | | | | | |



 \triangle

| PROJEC | HARRIS' | VILLE LIQUOR STORE |
|--------|-----------|--------------------|
| JOB No | o: 06031 | SCALE: AS NOTED |
| DRAWN | BY: SD | DESIGNED BY: KC |
| DATE: | 2-22-2006 | SA1.3 |

Attachment 8

| Γ | Ī | |
|---|---|-------------|
| | | > |
| | | - |
| | | > |
| | | |
| | | \ \ - |
| | | |
| | | |

| APF | LICABL | APPLICABLE CODES | |
|-------------------------------|--------|--------------------------|---------|
| | Year | | Year |
| International Building Code | 2003 | National Electrical Code | 2002 |
| International Mechanical Code | 2003 | Uniform Code for | |
| International Plumbing Code | 2003 | Building Conservation | 1997 |
| International Fire Code | 2003 | ADA Accessibility | |
| International Energy | | Guildelines | CURRENT |
| Conservation Code | 2003 | | |

| | | Þ | 0= |
|-------------------------------------|---------------------------------------|------------------------|-------------------|
| Special Use and Occupancy (e.g. Hig | Change in Use: Yes | Occupancy and Group: _ | Conservation Code |
| າcy (e.g. High | \ \ \ \ \ \ \ \ \ \ \ \ \ \ \ \ \ \ \ | | 2003 |
| h Rise, Covered Mall): | Mixed Occupancy: Yes | S-1 | |
| | × | | |
| | No | | |

Type of Construction **≯**|⊢ ⊳|Ħ (circle one): ⊳|Ħ 되 >|d \square

Design

Category:

mph

- Fire Resistance Rating Requirements fo separation distance (in hours):

 North: NA South: 1 HR East: NA

 Mixed Occupancies: Nonse

 Sprinklers: Provided: X Actual Area per Floor (square feet): 84

 Tabular Area: 9000

 Area Modifications: NOT REQUIRED
 - N N N N
- Nonseparated Uses:
- **Building Height:** Type of Sprinkler

<u>AUTOMATIC</u>

- 8410

- rea Modifications: NOT REQUIRED

a)
$$A_a = A_t + \left[\frac{A_t \ I_f}{100}\right] + \left[\frac{A_t \ I_s}{100}\right]$$

$$I_f = 100 \left[\frac{F}{P} - 0.25\right] \frac{W}{30}$$
a) $13500 = 9000 + \left[\frac{9000 \times .5}{100}\right] \left[\frac{A_t \ I_s}{100}\right]$

$$.5 = 100 \left[\frac{319}{422} - 0.25\right] \frac{30}{30}$$

Sum of the Ratio Calculations for Mixed Occ

- Actual Area
 Allowable Area ΙΛ _ 5660 (GROUP M) ≤ 2750 (GROUP S-1) ≤ 9000 _
- Total Allowable
- One Story:
 Two Story: Area for: 13500
- $A_a(2)_{-}$: $A_a(3)_{-}$
- d Area Building:

Resistance Rating Requirements for

Building

Elements (hours).

| | Fire Barriers | Partitions - Permanent | Structural Frame | Exterior Non-Bearing Walls | Interior Bearing Walls | Exterior Bearing Walls | Element |
|------------------|-----------------|------------------------|------------------|----------------------------|------------------------|-------------------------|---------------------|
| | 0 | 0 | 0 | 0 | 0 | 0* | Hours |
| | | | | | | | Assembly Listing |
| Smoke Partitions | Fire Partitions | Fire Walls | Shaft Enclosures | Exterior Doors and Windows | Roofs - Ceiling Roofs | Floors - Ceiling Floors | Element |
| | 0 | 0 | 0 | 0 | 0 | | Hours |
| | | | | | | | Assembly Listing |

- TH EXTERIOR BEARING WALL IS GREATER THAN 5' BUT LESS THAN 30' FROM THE PERTY LINE REQUIRING A 1HR RATING. THE WALL IS CONSTRUCTED OF 8X8X16 CMU EEDING THE 1HR RATING PER 2003 IBC TABLE 720.1.3 FOR CONCRETE MASONRY UNITS Design Occupant Load: 198

 Exit Width Required: 30 Exit Width Provided: 132
- Design Occupant Load Exit Width Required:

- linimum Number of Required Plumbing Facilities **(f)** (f) 1 Provided (m)_ Provided (m)__ (f)__
- Service Sinks:

- In case of conflict with the U.S. Department of Justice Federal Registers Parts I through

 → ADA Guidelines and specific reference to the International Building Code Accessibility Chapters, the more restrictive requirement shall govern.
- ditional Code Information shall be provided at the discretion of the Building icial for Complex Buildings. Including, but not limited to:

 High Rise Requirements.

 Atriums.

- Performance Based Criteria.
 Means or Egress Analysis.
 Fire Assembly Locator Sheet.
 Exterior and Interior Accessibility Route.
 Fire Stopping, Including Tested Design Number.

architecture

ADDENDUM

March 3, 2006

PROJECT

Ogden Patterson Liquor Store #24

OWNER

State of Utah, Department of Alcoholic Beverage Control

ARCHITECT

Eaton Architecture, LLC 77 West 200 South, Suite 302 Salt Lake City, Utah 84101

The original Contract Documents issued for the above stated project are amended as noted in this Addendum. It shall be the sole responsibility of the bidder to appropriately disseminate this information to all concerned parties prior to the assigned bid time and date, and to coordinate the Addendum with the Contract Documents.

Receipt of this Addendum shall be acknowledged by inserting its number in the appropriate space provided on the bid form. This Addendum consists of a total of twelve (12) 8½" x 11" sheets. If there are still unresolved questions after examining this Addendum, please submit those questions via telephone or facsimile as soon as possible so that an Addendum can be issued to clarify those issues prior to bid.

ITEMS

- 1. Drawing Sheet A502- Window Types and Details was missing from the web posting fore this project. The missing drawing file has now been included for viewing.
- 2. Grade elevation annotation has been included on the sheet C102- Grading Plan. Refer to this sheet for grading information rather than sheet AS101.
- 3. Door number 101B, pair store front entrance doors, will have an automatic door operator-Sargent 4000 Series (Pedestal mtd. actuator –exterior, wall mtd. interior, single cooperation at vestibule, or approved equal.
- 4. Information for the display cases by Jahabow Industries, Inc. as referenced in Reference Note #4 on sheet A101 can be obtained at Advanced Display & Store Fixtures, (801) 262-3414.
- 5. The symbol and note on the Symbol Legend on sheet A301 denotes an 8" C.M.U. wall with 1-1/2" metal channel furring. This note shall be disregarded and the exterior wall furring shall be 3-5/8" metal stud furring as shown on the floor plan on sheet A101 and on the wall sections on sheet A401.
- 6. Underfloor framing of platform office area will be 8" super "C" metal floor joists with 5/8" plywood decking sandwiched between ½" type X gypsum board and metal studs. Under floor area will be sprinklered.
- 7. The metal stud fascia/parapet framing shown on 01/A401 shall be 6" 24 ga. Metal stud framing per structural details 7/S-401 and 11/S-401.
- 8. Continuous reinforced concrete footings and retaining walls shall be installed for the two landings and stairs at the North side of the building per structural detail 2/S-101 and the attached retaining wall schedule.
- 9. The C.M.U. trash bin enclosure shall be located as shown on drawing sheet AS101 rather than as shown on sheet S-201.



- 10. Disregard the ramps from landings shown on sheet A202. Stairs shall be included as shown on sheets
 - A201 and A101. Sheet A202 is included only to show the alternate masonry pattern.
- 11. The elevations of the footings shall be coordinated with the grading elevations shown on sheet C102. Bottom of footings shall be maintained at 2'-6" minimum below top of grade. Footings shall step down to maintain this required depth along the North and South sides of the building. Steps in the footings shall be no greater than 2'-0". The top of the foundation wall shall be at 8" above finished floor height at the entire perimeter of the building.
- 12. The entry mat flooring called for in the Finish Schedule on sheet A104 shall be metal grille roll-up type mat with track strips by Pawling Corp.- Roll-deck EM60 or equal by C.S. Inc., Muncie, PA or R.C. Munson. The concrete floor will not need to be recessed at entry mat areas.
- 13. Fire Hydrant location is on the NW corner of Patterson Street and Brinker Blvd.
- 14. Accessible parking stall signs shall be located 5' above ground to the bottom of the sign.
- 15. Clarification of Guardrail railing is described on Addendum Dwg. #1
- 16. Clarification of clear dimension to lavatory facility is provided on Addendum Dwg. #2
- 17. Clarification of Signage requirements is shown on Addendum Dwg. # 3.
- 18. Electrical Addendum Items as listed below:

19. Sheet E0.1

Item #1 Add additional Lighting Fixture Type "OD" Sure-Lites AEL1-SD-LASER complete with lamps, 120volt.

20. Sheet E2.1

Item #2 Provide install and wire Four Type "OD' Lighting fixtures. Locate one above each outside public door and one above each of the man doors at the side of the building. Wire the additional outdoor emergency fixtures on circuit A-41.

21. Sheet E3.1

Item #1 All of the Fire Alarms System Horn/Strobes are to be 75 Candelas except the Restrooms @ 15 Candelas and loading area @ 30 Candelas.


23. LIST OF APPROVAL ITEMS


The following items, trade names, products and manufactures are approved for bidding. Approval does not relieve the bidder from satisfying the intent of the requirements of the drawings, specifications, and addenda in every respect. Failure to conform to the design quality and standards specified, established and required may result in later disapproval. If equipment must be disapproved after bidding, supplier shall supply specified equipment at no extra cost to the owner.


Items are listed generally and specific model number, etc. shall be as submitted. Items submitted but not approved either did not satisfy the requirements, or showed insufficient data, or arrived after the 8 day deadline established for the submittal process.




| Lighting Fixtures | | | | | | | |
|-------------------|----------|-----------|------------|--------------------------|--|--|--|
| A | Daybrite | Lithonia | LSI | Columbia | | | |
| ΑE | Daybrite | Lithonia | LSI | Columbia | | | |
| В | Daybrite | Lithonia | LSI | Columbia | | | |
| BE | Daybrite | Lithonia | LSI | Columbia | | | |
| C | Daybrite | Lithonia | LSI | Columbia | | | |
| D | Daybrite | Lithonia | LSI | Columbia | | | |
| E | Daybrite | Evenlight | Lightguard | Dual-Lite | | | |
| F | Daybrite | Lithonia | LSI | Columbia | | | |
| G | Daybrite | Gotham | LSI | Prescolite | | | |
| Н | Daybrite | Contech | LSI | Prescolite | | | |
| X1 | Daybrite | Evenlight | Lightguard | Dual-Lite | | | |
| OA | Daybrite | Lithonia | LSI | Architectural Area Light | | | |
| OB | Daybrite | Lithonia | LSI | Hubbell | | | |
| OC | Gardco | Lithonia | LSI | Kim | | | |

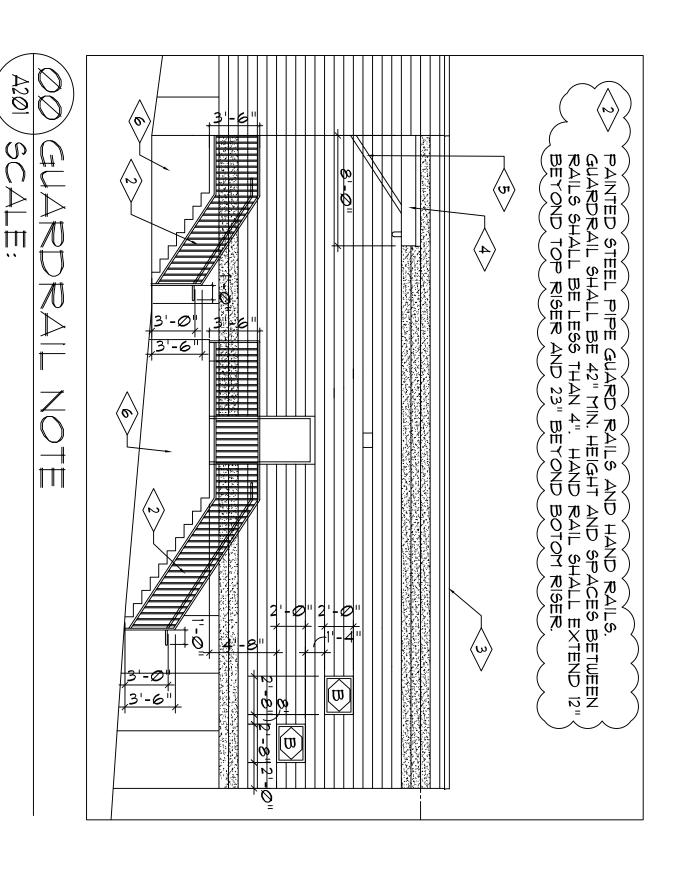

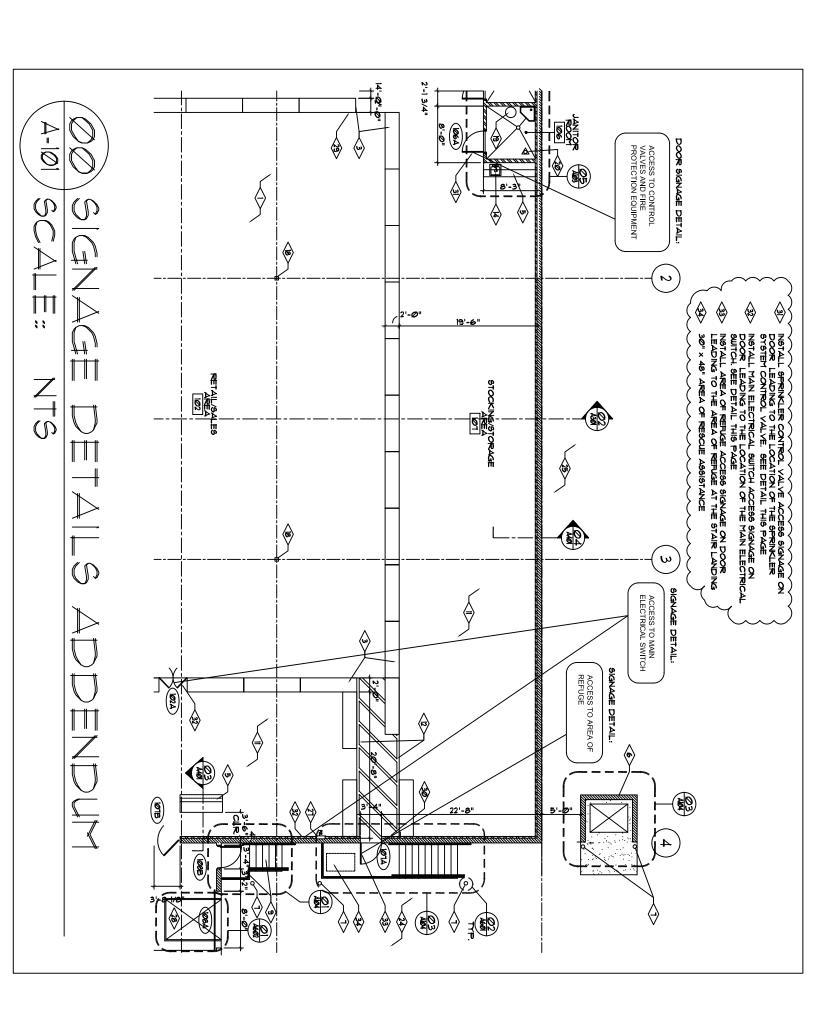

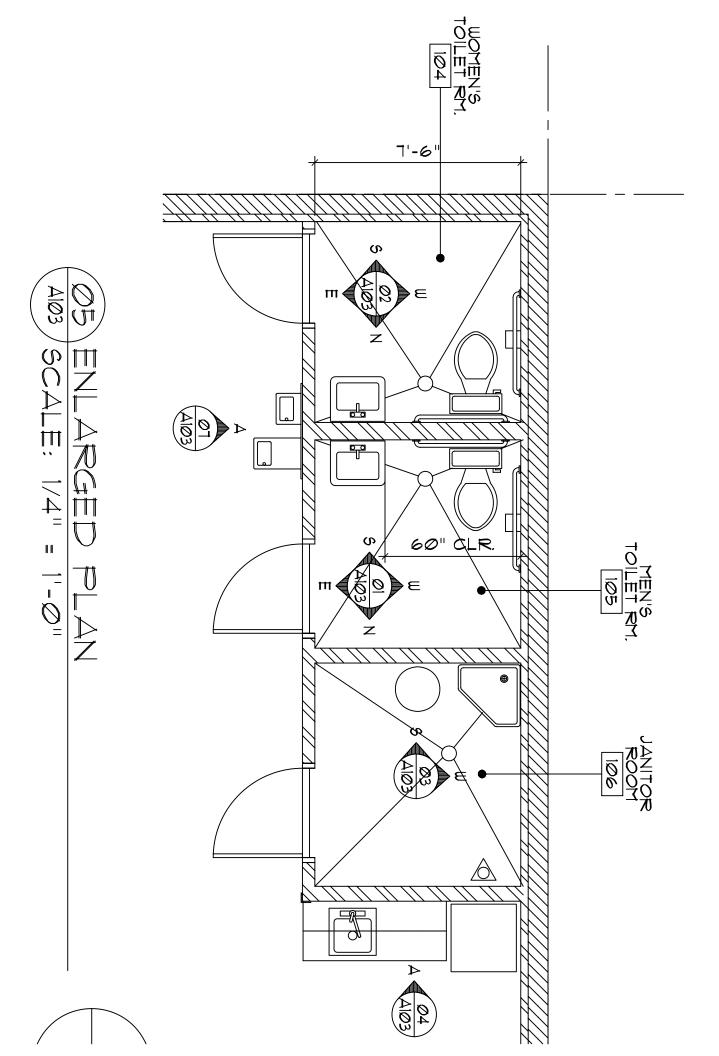

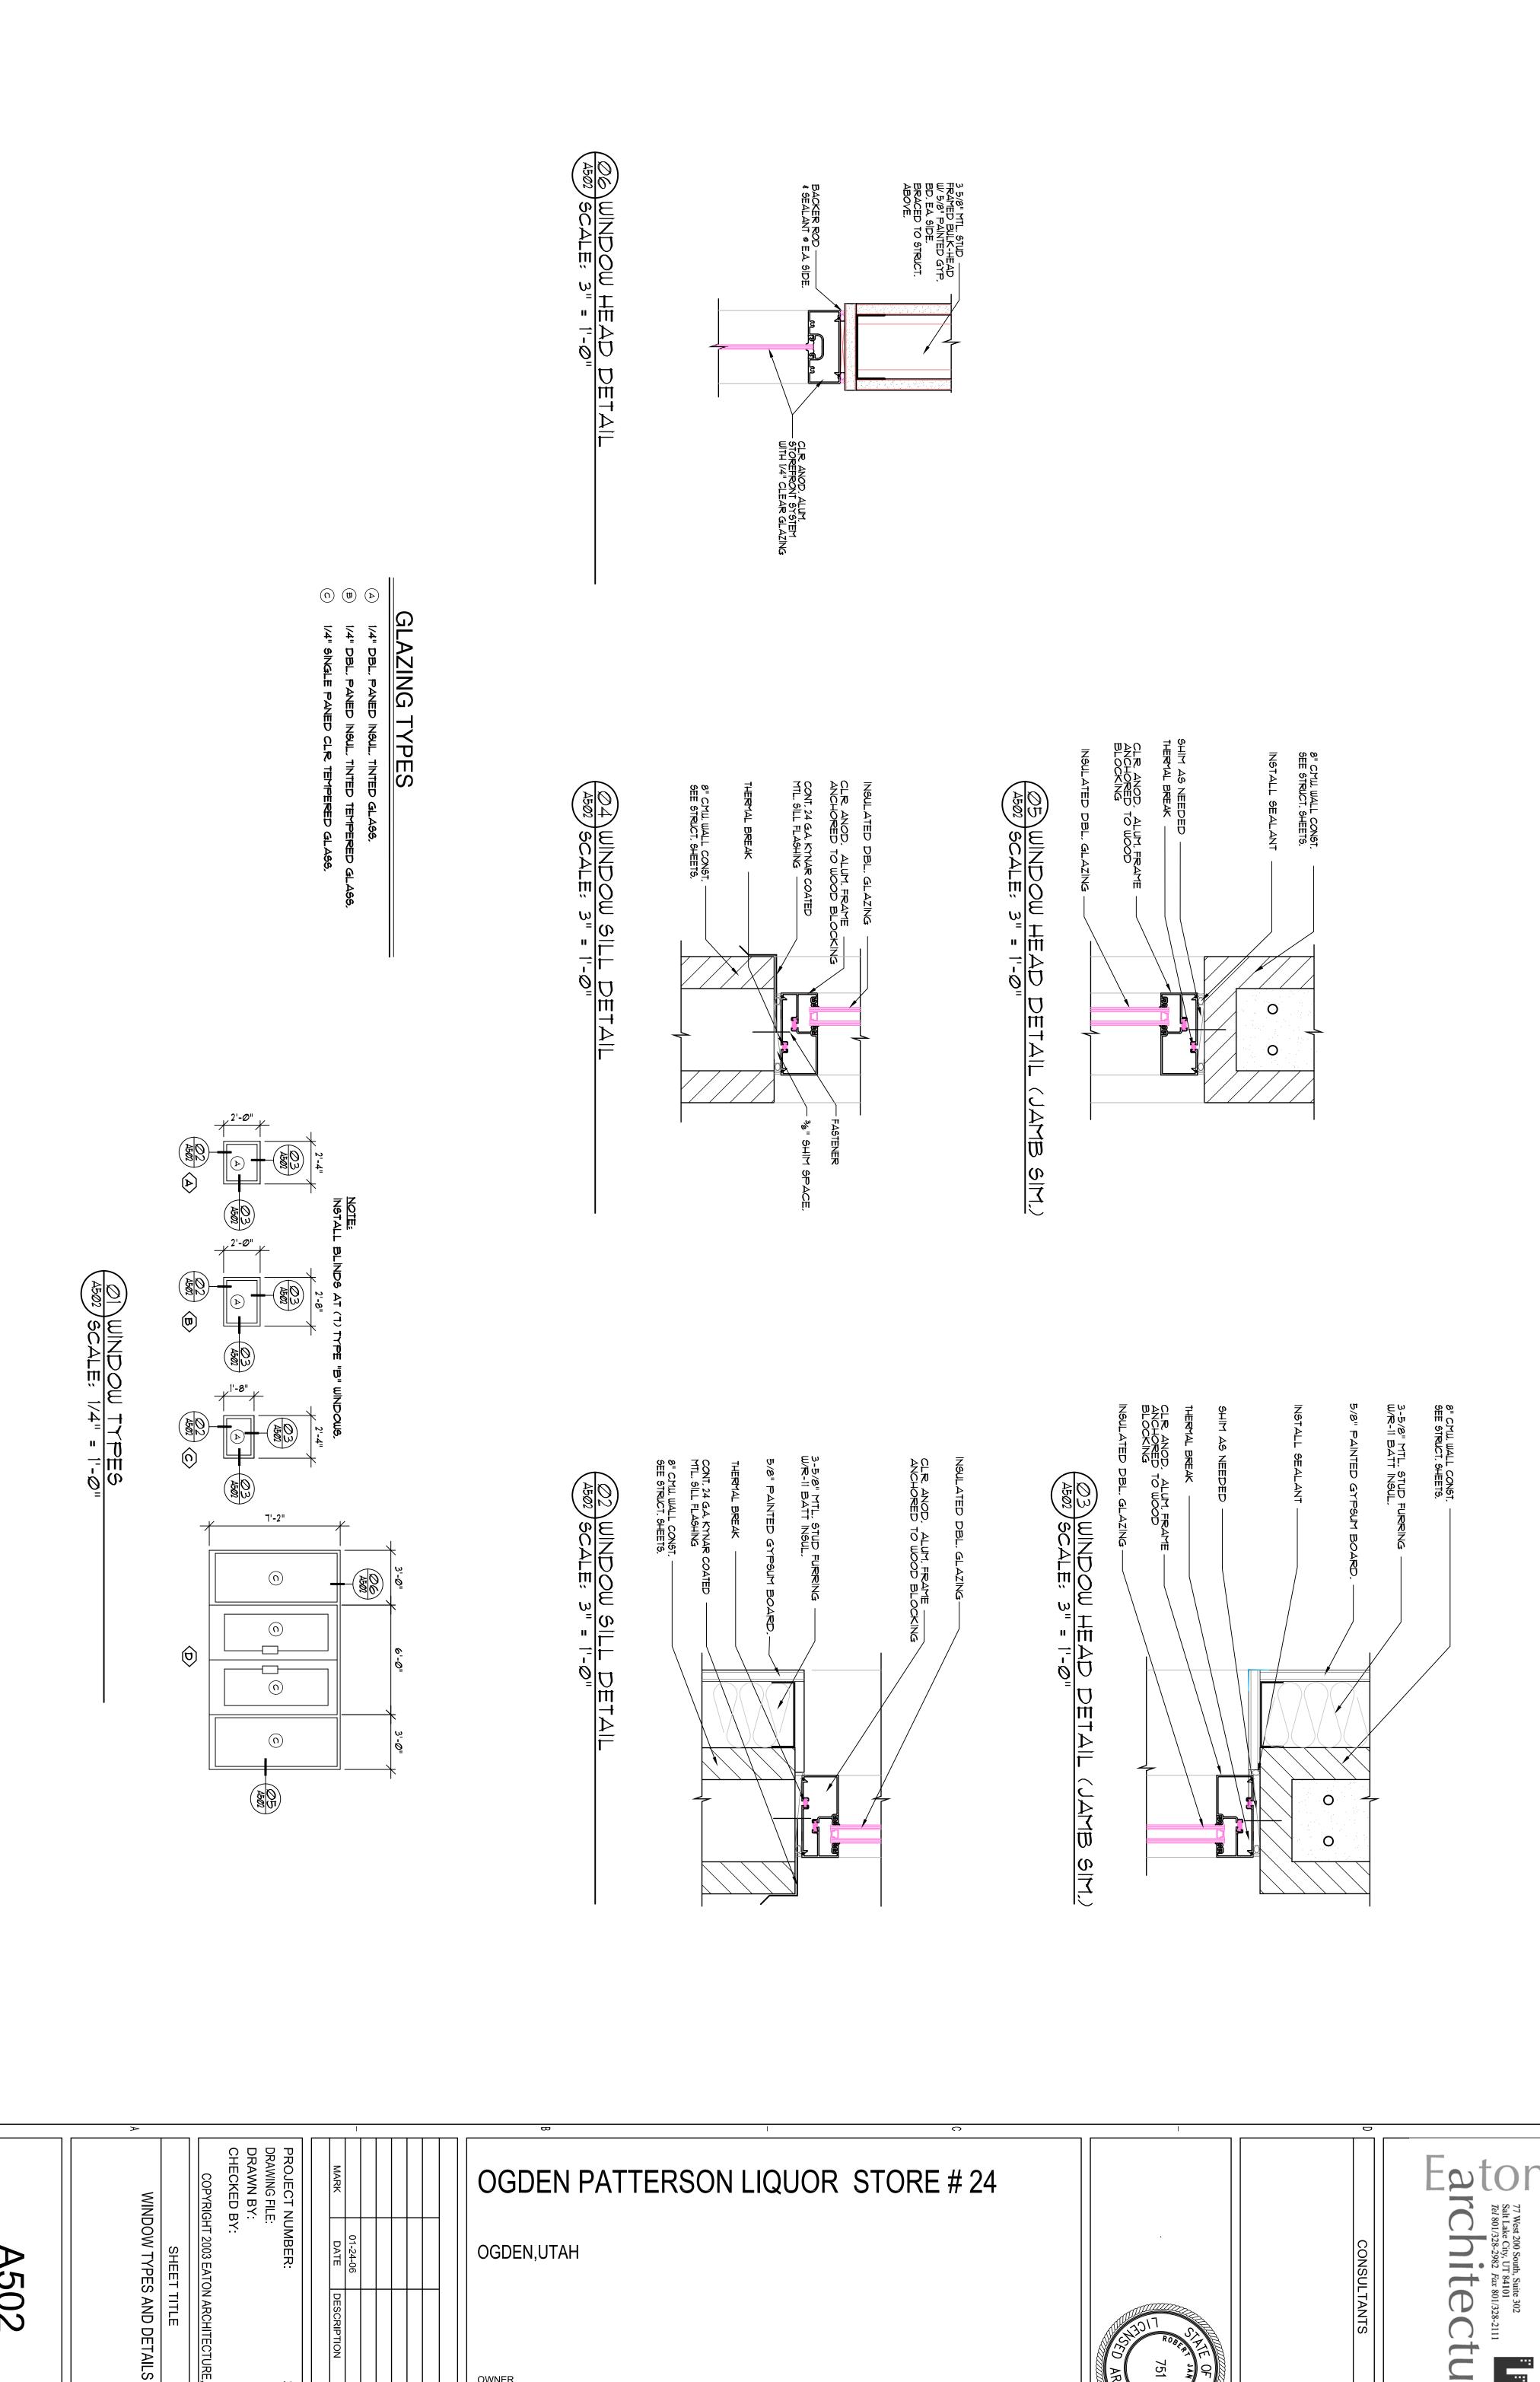

UTAH DEPARTMENT OF ALCOHOLIC BEVERAGE CONTROL

...:

A502

2005-13